

# **National Grid SA-COA**

## **PRODUCTION FILE**

**Contractor : ABB Contracting Co.**

**Project : SS 8709- 132/13.8kV in Alkharj City**

**Contract No : 11131113/00**

**Substation : 8709**

**Subject : 132Kv Busbar Protection Set-1 (+BBP1-5)  
Relay Panel-5**

**ABB**



POWER SYSTEMS NETWORK MANAGEMENT  
PROTECTION AND SUBSTATION AUTOMATION SYSTEMS  
WBS NO: S-13656

ABB AUTOMATION COMPANY LTD.  
414, AL-KHARJ ROAD  
SECOND INDUSTRIAL CITY  
RIYADH-11383 K.S.A

CONTRACTOR : ABB Contracting Company  
CLIENT : National GridSA  
PROJECT : CONSTRUCTION OF NEW 132/13.8kV SS 8709 IN AL-KHARJ CITY  
SUBSTATION : S/S 8709  
CONTRACT NO. : 11131113/00  
TITLE : Assembly Drawing - +BBP1-5  
[132KV BUSBAR PROTECTION MAIN-1 BAY UNIT PANEL]

AS-BUILT BY \_\_\_\_\_ DATE \_\_\_\_\_ CONTRACT NO. **11131113/00** JOB ORDER NO. **S-13656**

|           |              |                        |   |
|-----------|--------------|------------------------|---|
| <b>01</b> | <b>13 49</b> | <b>FACTORY ASBUILT</b> | DRAWN BY <b>RIZ</b> CHECKED BY <b>KVR</b>           |
| <b>00</b> | <b>13 05</b> | <b>FOR APPROVAL</b>    | DATE STARTED <b>28.01.2013</b> DATE COMPLETED _____ |
| REV. NO.  | DATE         | DESCRIPTION            | OPRG. DEPT. <b>CTPD</b> ENG. DEPT. <b>AUT-PSAC</b>  |


### COVER SHEET

**132KV BUSBAR PROT.N.MAIN-1 BU PANEL +BBP1-5**  
**S/S 8709 - 132/13.8KV IN AL-KHARJ CITY**  
**RIYADH SAUDI ARABIA**

الشركة الوطنية لنقل الكهرباء



| INDEX | PLANT NO.   | DRAWING NUMBER   | SHEET NO.      | REV. NO.  |
|-------|-------------|------------------|----------------|-----------|
| -     | <b>C421</b> | <b>CD-322998</b> | <b>G00 G01</b> | <b>01</b> |

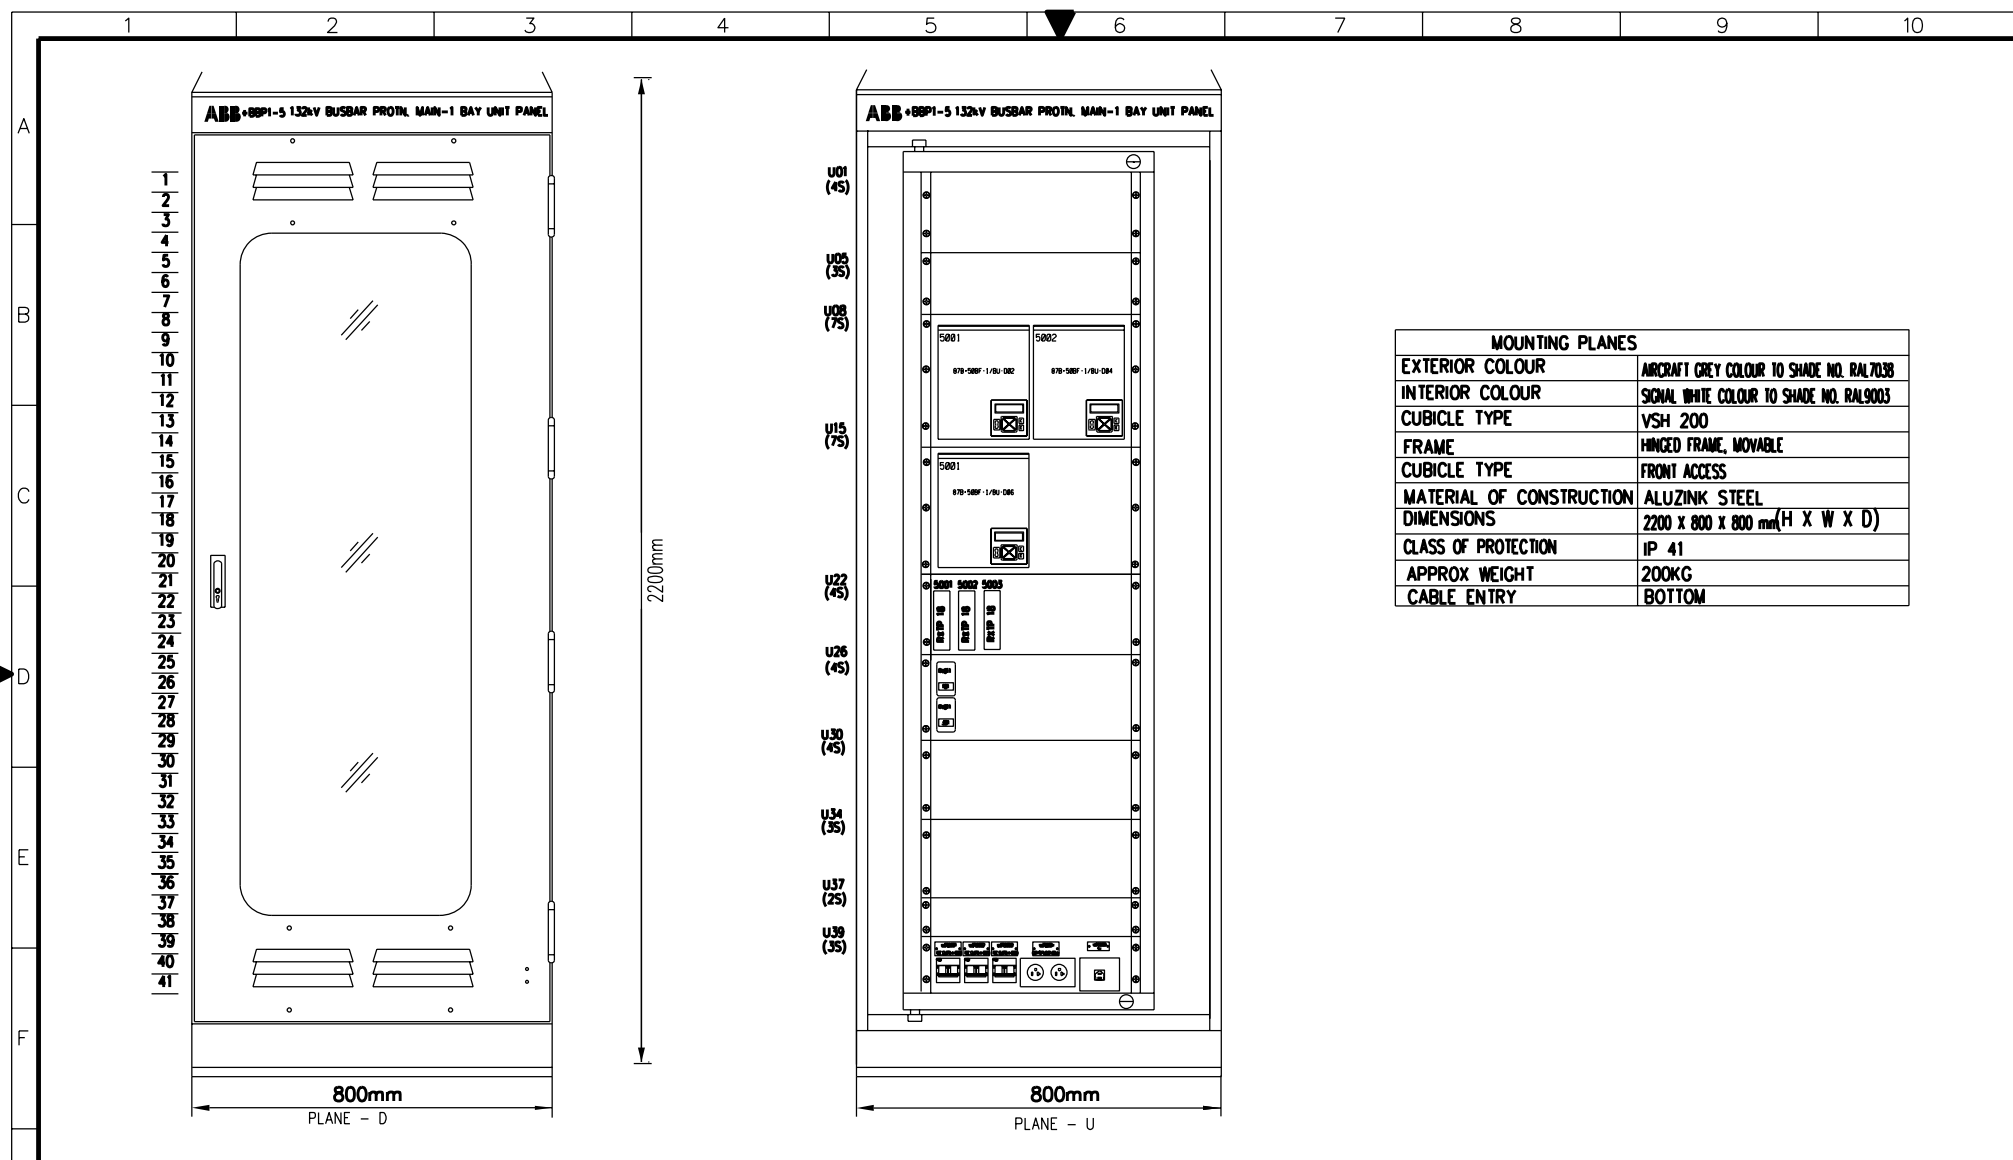

| MOUNTING PLANES          |   |
|--------------------------|---|
| EXTERIOR COLOUR          | AIRCRAFT GREY COLOUR TO SHADE NO. RAL7038 |
| INTERIOR COLOUR          | SIGNAL WHITE COLOUR TO SHADE NO. RAL9003  |
| CUBICLE TYPE             | VSH 200                                   |
| FRAME                    | HINGED FRAME, MOVABLE                     |
| CUBICLE TYPE             | FRONT ACCESS                              |
| MATERIAL OF CONSTRUCTION | ALUZINK STEEL                             |
| DIMENSIONS               | 2200 x 800 x 800 mm (H X W X D)           |
| CLASS OF PROTECTION      | IP 41                                     |
| APPROX. WEIGHT           | 200KG                                     |
| CABLE ENTRY              | BOTTOM                                    |

AS-BUILT BY \_\_\_\_\_ DATE \_\_\_\_\_

CONTRACT NO. 11131113/00

JOB ORDER NO. S-13656

01

13 49

FACTORY ASBUILT

00

13 05

FOR APPROVAL

REV. NO.

DATE

DESCRIPTION

DRAWN BY RIZ

CHECKED BY KVR

DATE STARTED 28.01.2013

DATE COMPLETED \_\_\_\_\_

OPRG. DEPT. CTPD

ENG. DEPT. AUT-PSAC

ASSEMBLY DRAWING


132KV BUSBAR PROTN.MAIN-1 BU PANEL +BBP1-5

S/S 8709 - 132/13.8KV IN AL-KHARJ CITY

RIYADH

SAUDI ARABIA

الشركة الوطنية لنقل الكهرباء



National Grid sa

INDEX

PLANT NO.

DRAWING NUMBER

SHEET NO.

SHT CONT.

REV. NO.

-


C421

CD-322998


G01

G02


01

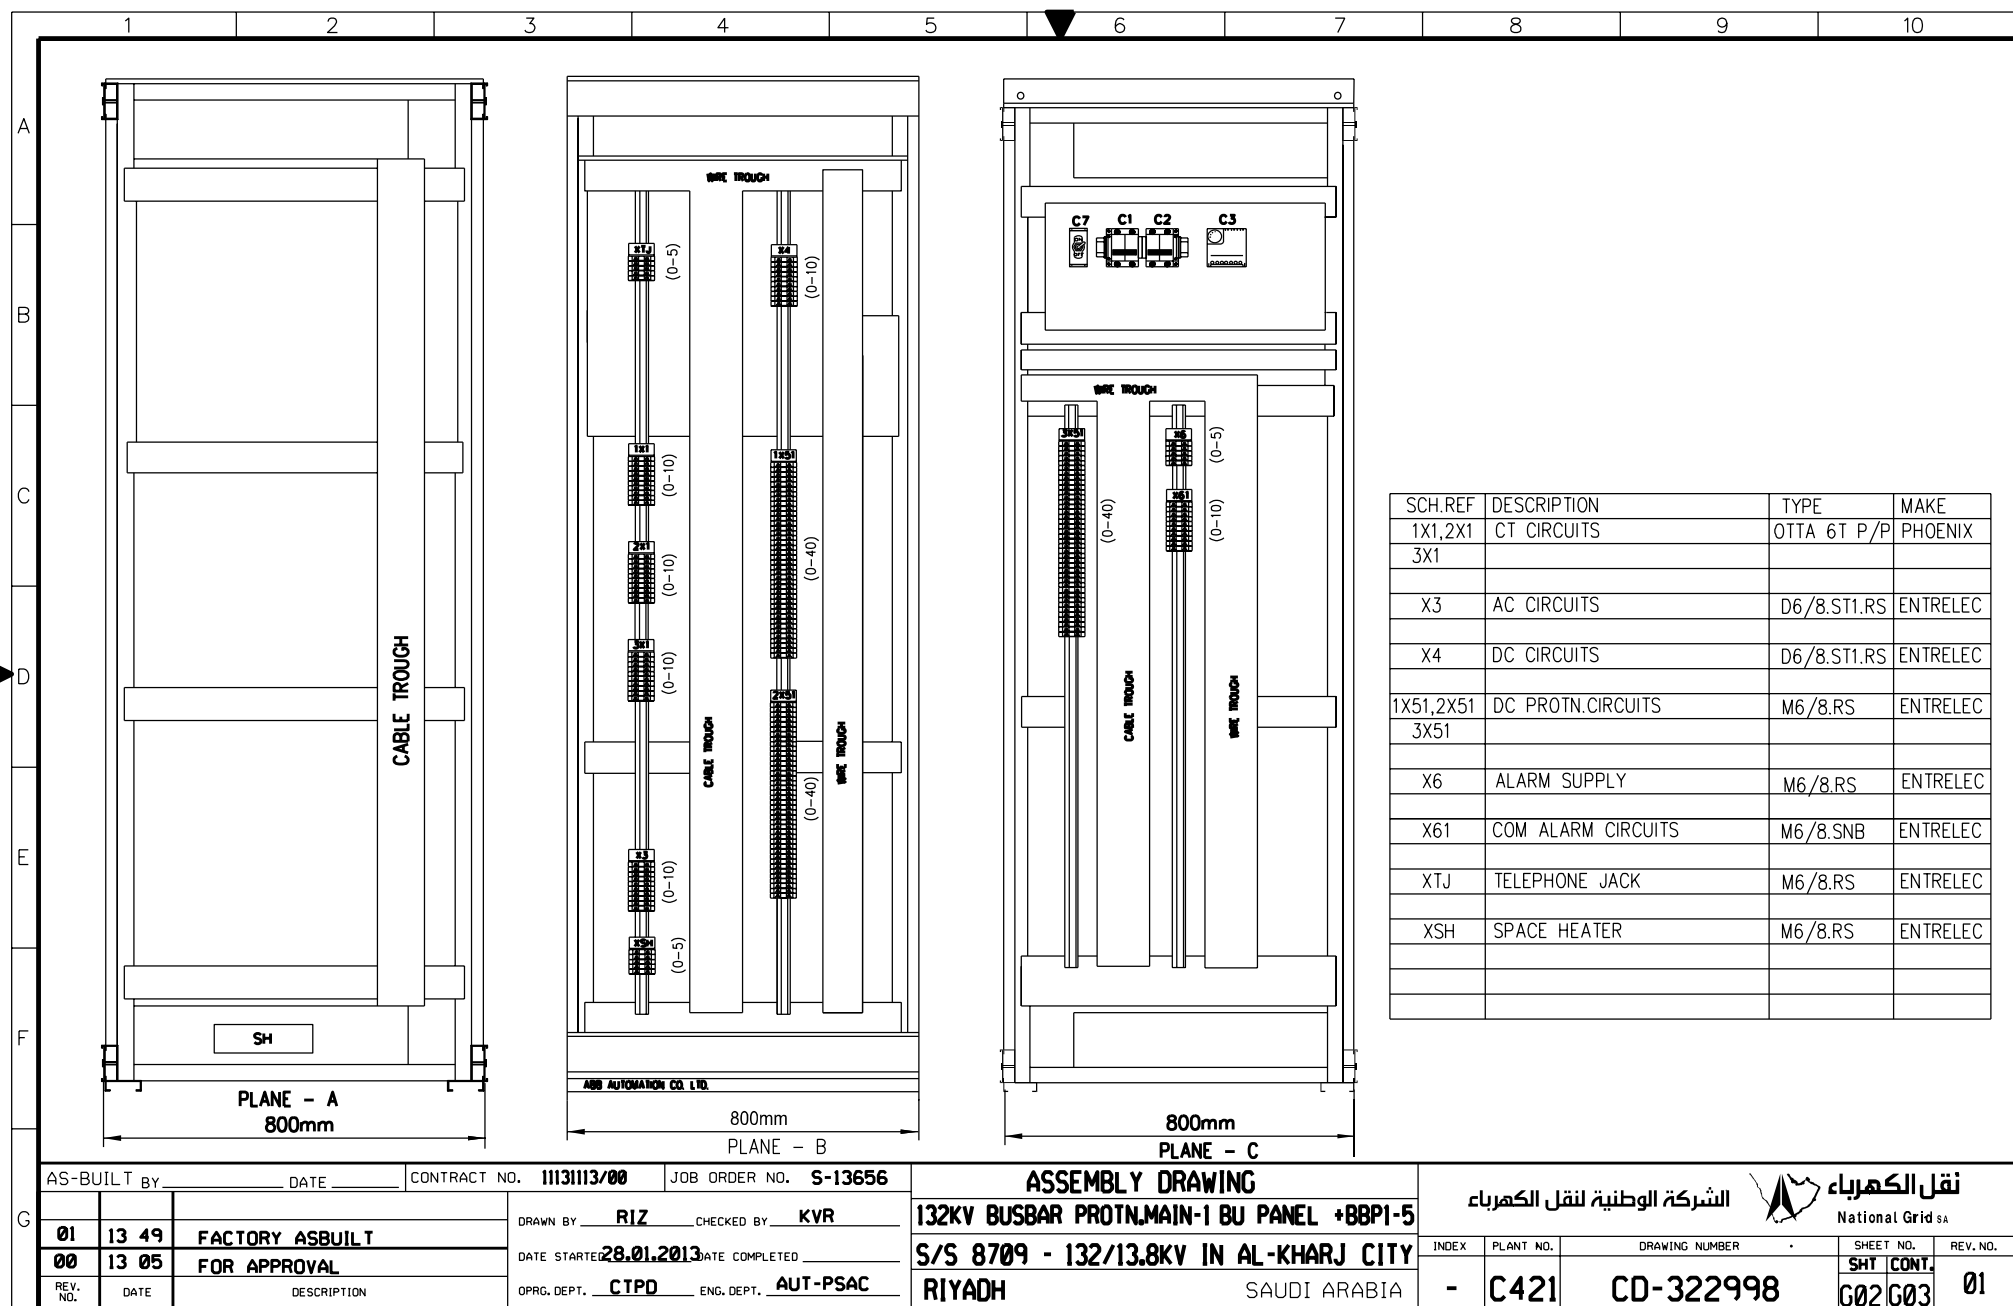

# BASE PLATE/ FOUNDATION

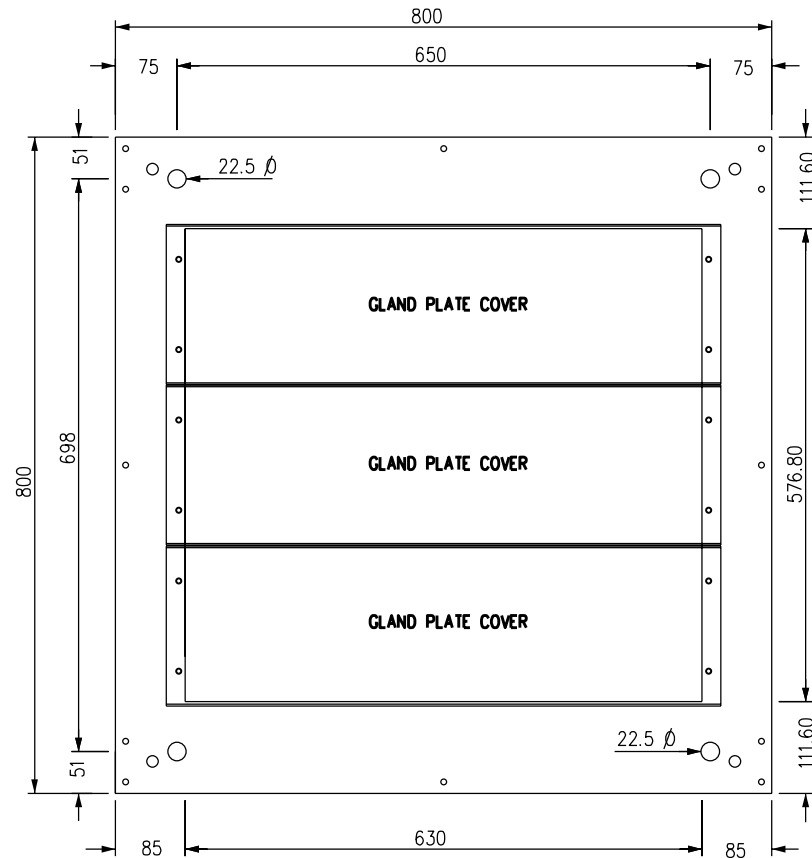

# PLAN

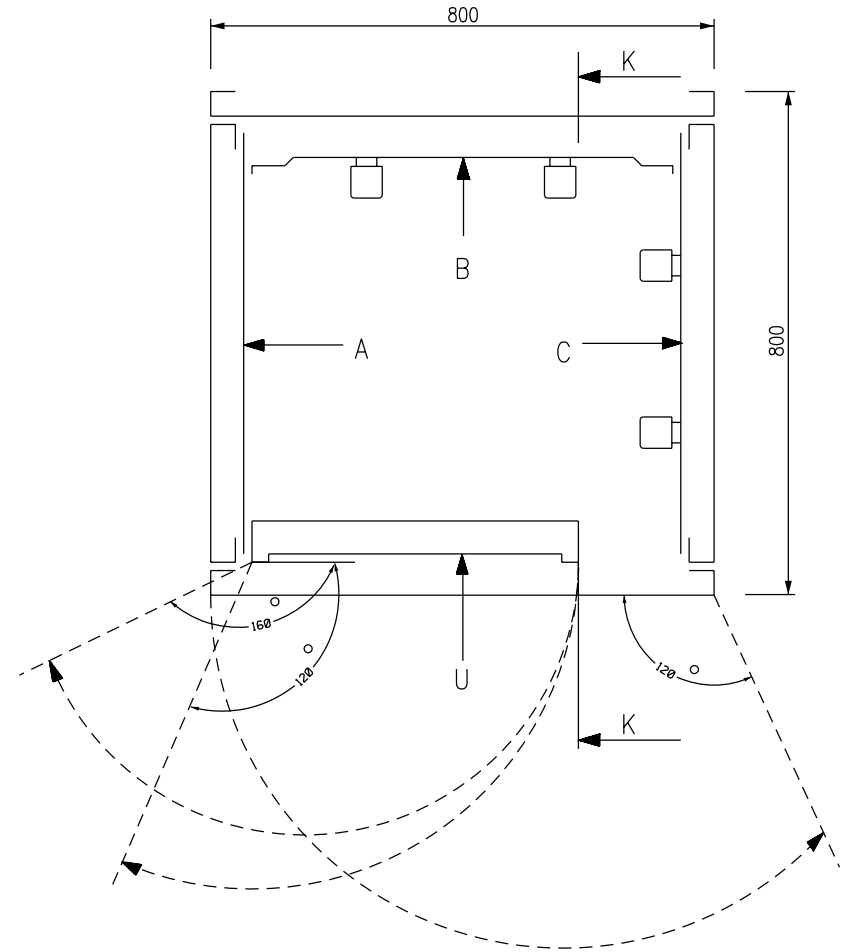

AS-BUILT BY \_\_\_\_\_ DATE \_\_\_\_\_ CONTRACT NO. **11131113/00** JOB ORDER NO. **S-13656**

| 01       | 13 49 | FACTORY ASBUILT |
|----------|-------|-----------------|
| 00       | 13 05 | FOR APPROVAL    |
| REV. NO. | DATE  | DESCRIPTION     |

DRAWN BY **RIZ** CHECKED BY **KVR**  
 DATE STARTED **28.01.2013** DATE COMPLETED \_\_\_\_\_  
 OPRG. DEPT. **CTPD** ENG. DEPT. **AUT-PSAC**

## ASSEMBLY DRAWING

**132KV BUSBAR PROTN.MAIN-1 BU PANEL +8BP1-5**  
**S/S 8709 - 132/13.8KV IN AL-KHARJ CITY**  
**RIYADH SAUDI ARABIA**

الشركة الوطنية لنقل الكهرباء



| INDEX | PLANT NO. | DRAWING NUMBER | SHEET NO.            | REV. NO. |
|-------|-----------|----------------|----------------------|----------|
| -     | C421      | CD-322998      | SHT CONT.<br>G03 G04 | 01       |

NG/D2-D (2012/01)

DMS VECTOR NGD200

THIS DRAWING AND THE INFORMATION CONTAINED HEREIN ARE THE SOLE PROPERTY OF NATIONAL GRID SA. NO REPRODUCTION IN FULL OR IN PART SHALL BE OBTAINED FROM THIS DOCUMENT WITHOUT THE WRITTEN CONSENT OF ITS OWNER.

|   | 1 | 2 | 3 | 4 | 5 | 6 | 7 | 8 | 9 | 10 |
|---|---|---|---|---|---|---|---|---|---|----|
| A |   |   |   |   |   |   |   |   |   |    |
| B |   |   |   |   |   |   |   |   |   |    |
| C |   |   |   |   |   |   |   |   |   |    |
| D |   |   |   |   |   |   |   |   |   |    |
| E |   |   |   |   |   |   |   |   |   |    |
| F |   |   |   |   |   |   |   |   |   |    |
| G |   |   |   |   |   |   |   |   |   |    |

TOP VIEW FOR EARTHING BAR

U PLANE TOP LABEL

U PLANE BOTTOM LABEL

MANUFACTURING LABEL

ABB Automation Co.Ltd.

PROJECT : National Grid SA S/S 8709

ORDER REFERENCE : 2875 RF S13656

YEAR OF MANUFACTURE: 2013

PANEL NO. : +BBP1-5

DRAWING NO. : S13656-CD-322999

MADE IN THE KINGDOM OF SAUDI ARABIA

|                              |  |                                      |  |  |  |  |  |                                |  |                    |  |
|------------------------------|--|--------------------------------------|--|--|--|--|--|--------------------------------|--|--------------------|--|
| AS-BUILT BY _____ DATE _____ |  | CONTRACT NO. 11131113/00             |  | JOB ORDER NO. S-13656                  |  | ASSEMBLY DRAWING                           |  | الشركة الوطنية لنقل الكهرباء   |  | نقل الكهرباء       |  |
| 01 13 49                     |  | FACTORY ASBUILT                      |  | DRAWN BY RIZ CHECKED BY KVR            |  | 132KV BUSBAR PROTN.MAIN-1 BU PANEL +BBP1-5 |  | National Grid sa               |  |                    |  |
| 00 13 05                     |  | FOR APPROVAL                         |  | DATE STARTED 28.01.2013 DATE COMPLETED |  | S/S 8709 - 132/13.8KV IN AL-KHARJ CITY     |  | INDEX PLANT NO. DRAWING NUMBER |  | SHEET NO. REV. NO. |  |
| REV. NO. DATE DESCRIPTION    |  | OPRG. DEPT. CTPD ENG. DEPT. AUT-PSAC |  | RİYADH SAUDI ARABIA                    |  | - C421 CD-322998                           |  | G04 L00                        |  | 01                 |  |



POWER SYSTEMS NETWORK MANAGEMENT  
PROTECTION AND SUBSTATION AUTOMATION SYSTEMS  
WBS NO: S-13656

ABB AUTOMATION COMPANY LTD  
414, AL-KHARJ ROAD  
SECOND INDUSTRIAL CITY  
RIYADH-11383 K.S.A

CONTRACTOR : ABB Contracting Company  
CLIENT : National Gridsa  
PROJECT : CONSTRUCTION OF NEW 132/13.8kV SS 8709 IN AL-KHARJ CITY  
SUBSTATION : S/S 8709  
CONTRACT NO. : 11131113/00  
TITLE : LIST OF APPARATUS - +BBP1-5  
[132KV BUSBAR PROTECTION MAIN-1 BAY UNIT PANEL]

AS-BUILT BY \_\_\_\_\_ DATE \_\_\_\_\_ CONTRACT NO. **11131113/00** JOB ORDER NO. **S-13656**

|          |       |                 |   |
|----------|-------|-----------------|---|
| 01       | 13 49 | FACTORY ASBUILT | DRAWN BY <b>RIZ</b> CHECKED BY <b>KVR</b>           |
| 00       | 13 05 | FOR APPROVAL    | DATE STARTED <b>28.01.2013</b> DATE COMPLETED _____ |
| REV. NO. | DATE  | DESCRIPTION     | OPRG. DEPT. <b>CTPD</b> ENG. DEPT. <b>AUT-PSAC</b>  |

### COVER SHEET

**132KV BUSBAR PROT.N.MAIN-1 BU PANEL +BBP1-5**  
**S/S 8709 - 132/13.8KV IN AL-KHARJ CITY**  
**RIYADH SAUDI ARABIA**

الشركة الوطنية لنقل الكهرباء



| INDEX | PLANT NO. | DRAWING NUMBER | SHEET NO.            | REV. NO. |
|-------|-----------|----------------|----------------------|----------|
| -     | C421      | CD-322998      | SHT CONT.<br>L00 L01 | 01       |








|  |   |   |   |   |   |   |   |   |   |    |
|--|---|---|---|---|---|---|---|---|---|----|
|  | 2 | 3 | 4 | 5 |  | 6 | 7 | 8 | 9 | 10 |
|--|---|---|---|---|---|---|---|---|---|----|

[illegible]

|   |  |  |  |  |                              |  |  |  |  |  |   |  |  |  |
|---|--|--|--|--|------------------------------|--|--|--|--|--|---|--|--|--|
| AS-BUILT BY _____ DATE _____  |  |  | CONTRACT NO. <b>11131113/00</b>  |  | JOB ORDER NO. <b>S-13656</b> |  | <b>LIST OF APPARATUS</b><br><b>132KV BUSBAR PROTN.MAIN-1 BU PANEL +B8P1-5</b><br><b>S/S 8709 - 132/13.8KV IN AL-KHARJ CITY</b><br><b>RIYADH SAUDI ARABIA</b> |  |  |  | <b>نقل الكهرباء</b><br><b>الشركة الوطنية لنقل الكهرباء</b><br> <b>National Grid SA</b> |  |  |  |
| <b>01</b> <b>13 49</b> <b>FACTORY ASBUILT</b><br><b>00</b> <b>13 05</b> <b>FOR APPROVAL</b> |  |  | DRAWN BY <b>RIZ</b> CHECKED BY <b>KVR</b><br>DATE STARTED <b>28.01.2013</b> DATE COMPLETED _____ |  |                              |  |  |  | INDEX PLANT NO. DRAWING NUMBER SHEET NO. REV. NO.<br><b>- C421 CD-322998 103104 01</b> |  |   |  |  |  |
| REV. NO. DATE DESCRIPTION<br>_____  |  |  | OPRG. DEPT. <b>CTPD</b> ENG. DEPT. <b>AUT-PSAC</b>   |  |                              |  |  |  |  |  |   |  |  |  |

|   | 1                            | 2       | 3                        | 4   | 5  | 6    | 7  | 8           | 9              | 10                   |
|---|------------------------------|---------|--------------------------|---|--|------|--|-------------|----------------|----------------------|
| A | SR. NO.                      | GA REF. | SCH. REF.                | D E S C R I P T I O N   |  | SHT. | QTY.                                       | TYPE        | MAKE           | ORDERING INFORMATION |
|   | 41                           |         | 1X1,2X1,3X1              | BLOT CONNECTING TERMINAL BLOCKS DISCONNECTIBLE FOR CT CIRCUITS        |  | 301  | 30   | OTTA 6T P/P | PHOENIX        | 0790462              |
| B |                              |         | X3                       | SPRING LOADED TERMINAL BLOCKS DISCONNECTIBLE FOR AC CIRCUITS          |  | 301  | 10   | D6/8.ST1.RS | ENTRELEC       | 1SNA 115 831 R0400   |
|   |                              |         | X4                       | SPRING LOADED TERMINAL BLOCK FOR DC EXT. CIRCUITS                     |  | 301  | 10   | D6/8.ST1.RS | ENTRELEC       | 1SNA 115 831 R0400   |
| C |                              |         | 1X51.2X51,3X51           | SPRING LOADED TERMINAL BLOCK FOR DC PROT.N. CIRCUITS(EACH40)          |  | 301  | 120  | M6/8.RS     | ENTRELEC       | 1SNA 115 685 R1200   |
|   |                              |         | X6                       | SPRING LOADED TERMINAL BLOCK FOR ALM CIRCUITS                         |  | 301  | 5  | M6/8.RS     | ENTRELEC       | 1SNA 115 685 R1200   |
| D |                              |         | X61                      | KNIFE TYPE TERMINAL BLOCKS DISCONNECTIBLE FOR STN.-COM ALARM CIRCUITS |  | 301  | 10   | M6/8.SNB    | ENTRELEC       | 1SNA 115 688 R2500   |
|   |                              |         | XTJ                      | SPRING LOADED TERMINAL BLOCK FOR TELEPHONE JACK                       |  | 301  | 4  | M6/8.RS     | ENTRELEC       | 1SNA 115 685 R1200   |
| E |                              |         | XSH                      | SPRING LOADED TERMINAL BLOCKS FOR SPACE HEATER                        |  | 301  | 2  | M6/8.RS     | ENTRELEC       | 1SNA 115 685 R1200   |
|   |                              |         |                          |   |  |      |  |             |                |                      |
| F |                              |         |                          |   |  |      |  |             |                |                      |
|   |                              |         |                          |   |  |      |  |             |                |                      |
| G | AS-BUILT BY _____ DATE _____ |         | CONTRACT NO. 11131113/00 |   | JOB ORDER NO. S-13656                        |      | LIST OF APPARATUS                          |             |                |                      |
|   | 01                           | 13 49   | FACTORY ASBUILT          |   | DRAWN BY RIZ CHECKED BY KVR                  |      | 132KV BUSBAR PROTN.MAIN-1 BU PANEL +8BP1-5 |             |                |                      |
|   | 00                           | 13 05   | FOR APPROVAL             |   | DATE STARTED 28.01.2013 DATE COMPLETED _____ |      | S/S 8709 - 132/13.8KV IN AL-KHARJ CITY     |             |                |                      |
|   | REV. NO.                     | DATE    | DESCRIPTION              |   | OPRG. DEPT. CTPD ENG. DEPT. AUT-PSAC         |      | RIYADH SAUDI ARABIA                        |             |                |                      |
|   |                              |         |                          |   |  |      | INDEX                                      | PLANT NO.   | DRAWING NUMBER | SHEET NO.            |
|   |                              |         |                          |   |  |      | -  | C421        | CD-322998      | CONT. L04/L05        |
|   |                              |         |                          |   |  |      |  |             | REV. NO.       | 01                   |

THIS DRAWING AND THE INFORMATION CONTAINED HEREIN ARE THE SOLE PROPERTY OF NATIONAL GRID SA. NO REPRODUCTION IN FULL OR IN PART SHALL BE OBTAINED FROM THIS DOCUMENT WITHOUT THE WRITTEN CONSENT OF ITS OWNER.

| LABEL REF. | LABEL ENGRAVING                   | MATERIALS           | ENGRAVING                            | LABEL SIZE | LETTER SIZE |
|------------|-----------------------------------|---------------------|--------------------------------------|------------|-------------|
| U08.5001   | U08.5001<br>878+508F-1/BU-D02     | TRAFOLITE           | BLACK LETTERS<br>ON WHITE BACKGROUND | 50X15mm    | 4mm         |
| U08.5002   | U08.5002<br>878+508F-1/BU-D04     | TRAFOLITE           | BLACK LETTERS<br>ON WHITE BACKGROUND | 50X15mm    | 4mm         |
| U15.5001   | U15.5001<br>878+508F-1/BU-D06     | TRAFOLITE           | BLACK LETTERS<br>ON WHITE BACKGROUND | 50X15mm    | 4mm         |
| U22.5001   | U22.5001<br>IS-1                  | ALUMINUM PAPER FOIL | BLACK LETTERS                        | 50X10mm    | 3mm         |
| U22.5002   | U22.5002<br>IS-2                  | ALUMINUM PAPER FOIL | BLACK LETTERS                        | 50X10mm    | 3mm         |
| U22.5003   | U22.5003<br>IS-3                  | ALUMINUM PAPER FOIL | BLACK LETTERS                        | 50X10mm    | 3mm         |
| U26.101    | U26.101<br>748F-1/D02             | ALUMINUM PAPER FOIL | BLACK LETTERS                        | 50X10mm    | 3mm         |
| U26.301    | U26.301<br>748F-1/D06             | ALUMINUM PAPER FOIL | BLACK LETTERS                        | 50X10mm    | 3mm         |
| U37.5001   | U37.5001<br>DC SUPPLY MCB FOR D02 | TRAFOLITE           | BLACK LETTERS<br>ON WHITE BACKGROUND | 50X15mm    | 4mm         |
| U37.5002   | U37.5002<br>DC SUPPLY MCB FOR D04 | TRAFOLITE           | BLACK LETTERS<br>ON WHITE BACKGROUND | 50X15mm    | 4mm         |
| U37.5003   | U37.5003<br>DC SUPPLY MCB FOR D06 | TRAFOLITE           | BLACK LETTERS<br>ON WHITE BACKGROUND | 50X15mm    | 4mm         |
| U37.5004   | U37.5004<br>C01-127V.C02-220V     | TRAFOLITE           | BLACK LETTERS<br>ON WHITE BACKGROUND | 50X15mm    | 4mm         |
| U37.5005   | U37.5005<br>IJ                    | TRAFOLITE           | BLACK LETTERS<br>ON WHITE BACKGROUND | 50X15mm    | 4mm         |
|            |                                   |                     |                                      |            |             |
|            |                                   |                     |                                      |            |             |

AS-BUILT BY \_\_\_\_\_ DATE \_\_\_\_\_ CONTRACT NO. **11131113/00** JOB ORDER NO. **S-13656**

|          |       |                 |   |
|----------|-------|-----------------|---|
| 01       | 13 49 | FACTORY ASBUILT | DRAWN BY <b>RIZ</b> CHECKED BY <b>KVR</b>           |
| 00       | 13 05 | FOR APPROVAL    | DATE STARTED <b>28.01.2013</b> DATE COMPLETED _____ |
| REV. NO. | DATE  | DESCRIPTION     | OPRG. DEPT. <b>CTPD</b> ENG. DEPT. <b>AUT-PSAC</b>  |

| LIST OF APPARATUS                                 |                     |
|---|---------------------|
| <b>132KV BUSBAR PROTN.MAIN-1 BU PANEL +88P1-5</b> |                     |
| <b>S/S 8709 - 132/13.8KV IN AL-KHARJ CITY</b>     |                     |
| <b>RIYADH</b>                                     | <b>SAUDI ARABIA</b> |

|                              |           |                  |           |
|------------------------------|-----------|------------------|-----------|
| الشركة الوطنية لنقل الكهرباء |           | نقل الكهرباء     |           |
|                              |           | National Grid sa |           |
| INDEX                        | PLANT NO. | DRAWING NUMBER   | SHEET NO. |
| -                            | C421      | CD-322998        | L06 L07   |
|                              |           | REV. NO.         | 01        |

| |
|---|
|                              | 1   | 2               | 3                        | 4 | 5                     | 6 | 7  | 8 | 9 | 10   | |
| A                            | |
| B                            | |
| C                            | |
| D                            | |
| E                            | |
| F                            | |
| G                            | <table><tr><td colspan="3">AS-BUILT BY _____ DATE _____</td><td colspan="2">CONTRACT NO. 11131113/00</td><td colspan="2">JOB ORDER NO. S-13656</td><td colspan="3">LIST OF APPARATUS</td><td colspan="2">الشركة الوطنية لنقل الكهرباء<br/>National Grid sa</td></tr><tr><td>01</td><td>13 49</td><td>FACTORY ASBUILT</td><td colspan="2">DRAWN BY RIZ</td><td colspan="2">CHECKED BY KVR</td><td colspan="3">132KV BUSBAR PROTN.MAIN-1 BU PANEL +B8P1-5</td><td>INDEX</td><td>PLANT NO.</td></tr><tr><td>00</td><td>13 05</td><td>FOR APPROVAL</td><td colspan="2">DATE STARTED 28.01.2013</td><td colspan="2">DATE COMPLETED _____</td><td colspan="3">S/S 8709 - 132/13.8KV IN AL-KHARJ CITY</td><td>DRAWING NUMBER</td><td>SHEET NO.</td></tr><tr><td>REV. NO.</td><td>DATE</td><td>DESCRIPTION</td><td colspan="2">OPRG. DEPT. CTPD</td><td colspan="2">ENG. DEPT. AUT-PSAC</td><td colspan="3">RIYADH SAUDI ARABIA</td><td>- C421</td><td>CD-322998</td></tr><tr><td colspan="10"></td><td>REV. NO.</td><td>01</td></tr></table> |                 |                          |   |                       |   |  |   |   |  | AS-BUILT BY _____ DATE _____ |  |  | CONTRACT NO. 11131113/00 |  | JOB ORDER NO. S-13656 |  | LIST OF APPARATUS |  |  | الشركة الوطنية لنقل الكهرباء<br>National Grid sa |  | 01 | 13 49 | FACTORY ASBUILT | DRAWN BY RIZ |  | CHECKED BY KVR |  | 132KV BUSBAR PROTN.MAIN-1 BU PANEL +B8P1-5 |  |  | INDEX | PLANT NO. | 00 | 13 05 | FOR APPROVAL | DATE STARTED 28.01.2013 |  | DATE COMPLETED _____ |  | S/S 8709 - 132/13.8KV IN AL-KHARJ CITY |  |  | DRAWING NUMBER | SHEET NO. | REV. NO. | DATE | DESCRIPTION | OPRG. DEPT. CTPD |  | ENG. DEPT. AUT-PSAC |  | RIYADH SAUDI ARABIA |  |  | - C421 | CD-322998 |  |  |  |  |  |  |  |  |  |  | REV. NO. | 01 |
| AS-BUILT BY _____ DATE _____ |   |                 | CONTRACT NO. 11131113/00 |   | JOB ORDER NO. S-13656 |   | LIST OF APPARATUS                          |   |   | الشركة الوطنية لنقل الكهرباء<br>National Grid sa | |
| 01                           | 13 49   | FACTORY ASBUILT | DRAWN BY RIZ             |   | CHECKED BY KVR        |   | 132KV BUSBAR PROTN.MAIN-1 BU PANEL +B8P1-5 |   |   | INDEX  | PLANT NO.                    | |
| 00                           | 13 05   | FOR APPROVAL    | DATE STARTED 28.01.2013  |   | DATE COMPLETED _____  |   | S/S 8709 - 132/13.8KV IN AL-KHARJ CITY     |   |   | DRAWING NUMBER                                   | SHEET NO.                    | |
| REV. NO.                     | DATE  | DESCRIPTION     | OPRG. DEPT. CTPD         |   | ENG. DEPT. AUT-PSAC   |   | RIYADH SAUDI ARABIA                        |   |   | - C421   | CD-322998                    | |
|                              |   |                 |                          |   |                       |   |  |   |   | REV. NO.   | 01                           | |

NG/D2-D (2012/01)  
VECTOR NGD200

THIS DRAWING AND THE INFORMATION CONTAINED HEREIN ARE THE SOLE PROPERTY OF NATIONAL GRID SA. NO REPRODUCTION IN FULL OR IN PART SHALL BE OBTAINED FROM THIS DOCUMENT WITHOUT THE WRITTEN CONSENT OF ITS OWNER.



POWER SYSTEMS NETWORK MANAGEMENT  
PROTECTION AND SUBSTATION AUTOMATION SYSTEMS  
WBS NO: S-13656

ABB AUTOMATION COMPANY LTD.  
414, AL-KHARJ ROAD  
SECOND INDUSTRIAL CITY  
RIYADH-11383 K.S.A

CONTRACTOR : ABB Contracting Company  
CLIENT : National Gridsa  
PROJECT : CONSTRUCTION OF NEW 132/13.8kV SS 8709 IN AL-KHARJ CITY  
SUBSTATION : S/S 8709  
CONTRACT NO. : 11131113/00  
TITLE : SCHEMATICS DRAWINGS - +BBP1-5  
[132KV BUSBAR PROTECTION MAIN-1 BAY UNIT PANEL]

AS-BUILT BY \_\_\_\_\_ DATE \_\_\_\_\_ CONTRACT NO. **11131113/00** JOB ORDER NO. **S-13656**

|    |       |                 |
|----|-------|-----------------|
| 01 | 13 49 | FACTORY ASBUILT |
| 00 | 13 05 | FOR APPROVAL    |

DRAWN BY **RIZ** CHECKED BY **KVR**

DATE STARTED **28.01.2013** DATE COMPLETED \_\_\_\_\_

OPRG. DEPT. **CTPD** ENG. DEPT. **AUT-PSAC**

### COVER SHEET

**132KV BUSBAR PROTN.MAIN-1 BU PANEL +BBP1-5**

**S/S 8709 - 132/13.8KV IN AL-KHARJ CITY**

**RIYADH**

**SAUDI ARABIA**

الشركة الوطنية لنقل الكهرباء



نقل الكهرباء  
National Grid sa

| INDEX | PLANT NO. | DRAWING NUMBER | SHEET NO.         | REV. NO. |
|-------|-----------|----------------|-------------------|----------|
| -     | C421      | CD-322999      | SHT 000 CONT. 001 | 01       |

NG/D2-D (2012/01)

DMS

VECTOR

NGD200

|   | 1   | 2      | 3      | 4      | 5 | 6              | 7              | 8      | 9      | 10     | |
|---|
| A   | <table border="1" style="width:100%; border-collapse: collapse;"> <tr> <th style="width:30%;">CONTENTS</th> <th style="width:10%;">ABB<br/>SHT.NO.</th> <th style="width:10%;">REV.00</th> <th style="width:10%;">REV.01</th> <th style="width:10%;">REV.02</th> </tr> <tr><td>COVER SHEET</td><td>000</td><td>X</td><td>X</td><td></td></tr> <tr><td>CONTENTS SHEET</td><td>001</td><td>X</td><td>X</td><td></td></tr> <tr><td>GRAPHICAL SYMBOLS FOR DIAGRAMS</td><td>011</td><td>X</td><td>X</td><td></td></tr> <tr><td>GRAPHICAL SYMBOLS FOR DIAGRAMS</td><td>012</td><td>X</td><td>X</td><td></td></tr> <tr><td>COMMON LEGEND</td><td>013</td><td>X</td><td>X</td><td></td></tr> <tr><td>FERRULE AND WIRING DETAILS</td><td>014</td><td>X</td><td>X</td><td></td></tr> <tr><td>DRAWING REFERENCES</td><td>015</td><td>X</td><td>X</td><td></td></tr> <tr><td>DRAWING REFERENCES</td><td>016</td><td>X</td><td>X</td><td></td></tr> <tr><td>PRIMARY SYSTEM</td><td>051-056</td><td>X</td><td>X</td><td></td></tr> <tr><td>AC SUPPLY FOR ILLUMINATION &amp; POWER SOCKET</td><td>211</td><td>X</td><td>X</td><td></td></tr> <tr><td>CUB. LIGHTING, HEATER &amp; SOCKET ALARM CKT.</td><td>212</td><td>X</td><td>X</td><td></td></tr> <tr><td>DC SUPPLY DISTRIBUTION</td><td>216</td><td>X</td><td>X</td><td></td></tr> <tr><td>CURRENT TRANSFORMER INPUTS -87B+50BF-1/BU-D02</td><td>221</td><td>X</td><td>X</td><td></td></tr> <tr><td>CURRENT TRANSFORMER INPUTS -87B+50BF-1/BU-D04</td><td>222</td><td>X</td><td>X</td><td></td></tr> <tr><td>CURRENT TRANSFORMER INPUTS -87B+50BF-1/BU-D06</td><td>223</td><td>X</td><td>X</td><td></td></tr> <tr><td>87B+50BF-1/BU-D02 PROTN.RELAY-BINARY INPUTS</td><td>231</td><td>X</td><td>X</td><td></td></tr> <tr><td>87B+50BF-1/BU-D02 PROTN.RELAY-BINARY INPUTS</td><td>232</td><td>X</td><td>X</td><td></td></tr> <tr><td>CBF-1 &amp; BUSBAR PROTN-1 TRIP RELAY CIRCUIT</td><td>233</td><td>X</td><td>X</td><td></td></tr> <tr><td>87B+50BF-1/BU-D04 PROTN.RELAY-BINARY INPUTS</td><td>234</td><td>X</td><td>X</td><td></td></tr> <tr><td>87B+50BF-1/BU-D04 PROTN.RELAY-BINARY INPUTS</td><td>235</td><td>X</td><td>X</td><td></td></tr> <tr><td>CBF-1 &amp; BUSBAR PROTN-1 TRIP RELAY CIRCUIT</td><td>236</td><td>X</td><td>X</td><td></td></tr> <tr><td>87B+50BF-1/BU-D06 PROTN.RELAY-BINARY INPUTS</td><td>237</td><td>X</td><td>X</td><td></td></tr> <tr><td>87B+50BF-1/BU-D06 PROTN.RELAY-BINARY INPUTS</td><td>238</td><td>X</td><td>X</td><td></td></tr> <tr><td>CBF-1 &amp; BUSBAR PROTN-1 TRIP RELAY CIRCUIT</td><td>239</td><td>X</td><td>X</td><td></td></tr> <tr><td> </td><td></td><td></td><td></td><td></td></tr> <tr><td> </td><td></td><td></td><td></td><td></td></tr> </table> |        |        |        |   | CONTENTS       | ABB<br>SHT.NO. | REV.00 | REV.01 | REV.02 | COVER SHEET | 000 | X | X |  | CONTENTS SHEET | 001 | X | X |  | GRAPHICAL SYMBOLS FOR DIAGRAMS | 011 | X | X |  | GRAPHICAL SYMBOLS FOR DIAGRAMS | 012 | X | X |  | COMMON LEGEND | 013 | X | X |  | FERRULE AND WIRING DETAILS | 014 | X | X |  | DRAWING REFERENCES | 015 | X | X |  | DRAWING REFERENCES | 016 | X | X |  | PRIMARY SYSTEM | 051-056 | X | X |  | AC SUPPLY FOR ILLUMINATION & POWER SOCKET | 211 | X | X |  | CUB. LIGHTING, HEATER & SOCKET ALARM CKT. | 212 | X | X |  | DC SUPPLY DISTRIBUTION | 216 | X | X |  | CURRENT TRANSFORMER INPUTS -87B+50BF-1/BU-D02 | 221 | X | X |  | CURRENT TRANSFORMER INPUTS -87B+50BF-1/BU-D04 | 222 | X | X |  | CURRENT TRANSFORMER INPUTS -87B+50BF-1/BU-D06 | 223 | X | X |  | 87B+50BF-1/BU-D02 PROTN.RELAY-BINARY INPUTS | 231 | X | X |  | 87B+50BF-1/BU-D02 PROTN.RELAY-BINARY INPUTS | 232 | X | X |  | CBF-1 & BUSBAR PROTN-1 TRIP RELAY CIRCUIT | 233 | X | X |  | 87B+50BF-1/BU-D04 PROTN.RELAY-BINARY INPUTS | 234 | X | X |  | 87B+50BF-1/BU-D04 PROTN.RELAY-BINARY INPUTS | 235 | X | X |  | CBF-1 & BUSBAR PROTN-1 TRIP RELAY CIRCUIT | 236 | X | X |  | 87B+50BF-1/BU-D06 PROTN.RELAY-BINARY INPUTS | 237 | X | X |  | 87B+50BF-1/BU-D06 PROTN.RELAY-BINARY INPUTS | 238 | X | X |  | CBF-1 & BUSBAR PROTN-1 TRIP RELAY CIRCUIT | 239 | X | X |  |  |  |  |  |  |  |  |  |  |  | <table border="1" style="width:100%; border-collapse: collapse;"> <tr> <th style="width:30%;">CONTENTS</th> <th style="width:10%;">ABB<br/>SHT.NO.</th> <th style="width:10%;">REV.00</th> <th style="width:10%;">REV.01</th> <th style="width:10%;">REV.02</th> </tr> <tr><td>COMMON ALARM CIRCUITS</td><td>292</td><td>X</td><td>X</td><td></td></tr> <tr><td>BLOCK REFERENCE 87B+50BF-1/BU-D02</td><td>293</td><td>X</td><td>X</td><td></td></tr> <tr><td>BLOCK REFERENCE 87B+50BF-1/BU-D02</td><td>294</td><td>X</td><td>X</td><td></td></tr> <tr><td>BLOCK REFERENCE 87B+50BF-1/BU-D04</td><td>295</td><td>X</td><td>X</td><td></td></tr> <tr><td>BLOCK REFERENCE 87B+50BF-1/BU-D04</td><td>296</td><td>X</td><td>X</td><td></td></tr> <tr><td>BLOCK REFERENCE 87B+50BF-1/BU-D06</td><td>297</td><td>X</td><td>X</td><td></td></tr> <tr><td>BLOCK REFERENCE 87B+50BF-1/BU-D06</td><td>298</td><td>X</td><td>X</td><td></td></tr> <tr><td>TERMINAL BLOCKS REFERENCE</td><td>301</td><td>X</td><td>X</td><td></td></tr> <tr><td> </td><td></td><td></td><td></td><td></td></tr> <tr><td> </td><td></td><td></td><td></td><td></td></tr> <tr><td> </td><td></td><td></td><td></td><td></td></tr> <tr><td> </td><td></td><td></td><td></td><td></td></tr> <tr><td> </td><td></td><td></td><td></td><td></td></tr> <tr><td> </td><td></td><td></td><td></td><td></td></tr> <tr><td> </td><td></td><td></td><td></td><td></td></tr> <tr><td> </td><td></td><td></td><td></td><td></td></tr> <tr><td> </td><td></td><td></td><td></td><td></td></tr> <tr><td> </td><td></td><td></td><td></td><td></td></tr> <tr><td> </td><td></td><td></td><td></td><td></td></tr> </table> |  |  |  |  | CONTENTS | ABB<br>SHT.NO. | REV.00 | REV.01 | REV.02 | COMMON ALARM CIRCUITS | 292 | X | X |  | BLOCK REFERENCE 87B+50BF-1/BU-D02 | 293 | X | X |  | BLOCK REFERENCE 87B+50BF-1/BU-D02 | 294 | X | X |  | BLOCK REFERENCE 87B+50BF-1/BU-D04 | 295 | X | X |  | BLOCK REFERENCE 87B+50BF-1/BU-D04 | 296 | X | X |  | BLOCK REFERENCE 87B+50BF-1/BU-D06 | 297 | X | X |  | BLOCK REFERENCE 87B+50BF-1/BU-D06 | 298 | X | X |  | TERMINAL BLOCKS REFERENCE | 301 | X | X | |
| CONTENTS                                      |   |        |        |        |   | ABB<br>SHT.NO. | REV.00         | REV.01 | REV.02 | |
| COVER SHEET                                   |   |        |        |        |   | 000            | X              | X      | |
| CONTENTS SHEET                                |   |        |        |        |   | 001            | X              | X      | |
| GRAPHICAL SYMBOLS FOR DIAGRAMS                |   |        |        |        |   | 011            | X              | X      | |
| GRAPHICAL SYMBOLS FOR DIAGRAMS                |   |        |        |        |   | 012            | X              | X      | |
| COMMON LEGEND                                 |   |        |        |        |   | 013            | X              | X      | |
| FERRULE AND WIRING DETAILS                    |   |        |        |        |   | 014            | X              | X      | |
| DRAWING REFERENCES                            |   |        |        |        |   | 015            | X              | X      | |
| DRAWING REFERENCES                            |   |        |        |        |   | 016            | X              | X      | |
| PRIMARY SYSTEM                                |   |        |        |        |   | 051-056        | X              | X      | |
| AC SUPPLY FOR ILLUMINATION & POWER SOCKET     |   |        |        |        |   | 211            | X              | X      | |
| CUB. LIGHTING, HEATER & SOCKET ALARM CKT.     |   |        |        |        |   | 212            | X              | X      | |
| DC SUPPLY DISTRIBUTION                        |   |        |        |        |   | 216            | X              | X      | |
| CURRENT TRANSFORMER INPUTS -87B+50BF-1/BU-D02 |   |        |        |        |   | 221            | X              | X      | |
| CURRENT TRANSFORMER INPUTS -87B+50BF-1/BU-D04 |   |        |        |        |   | 222            | X              | X      | |
| CURRENT TRANSFORMER INPUTS -87B+50BF-1/BU-D06 |   |        |        |        |   | 223            | X              | X      | |
| 87B+50BF-1/BU-D02 PROTN.RELAY-BINARY INPUTS   |   |        |        |        |   | 231            | X              | X      | |
| 87B+50BF-1/BU-D02 PROTN.RELAY-BINARY INPUTS   |   |        |        |        |   | 232            | X              | X      | |
| CBF-1 & BUSBAR PROTN-1 TRIP RELAY CIRCUIT     |   |        |        |        |   | 233            | X              | X      | |
| 87B+50BF-1/BU-D04 PROTN.RELAY-BINARY INPUTS   | 234   | X      | X      | |
| 87B+50BF-1/BU-D04 PROTN.RELAY-BINARY INPUTS   | 235   | X      | X      | |
| CBF-1 & BUSBAR PROTN-1 TRIP RELAY CIRCUIT     | 236   | X      | X      | |
| 87B+50BF-1/BU-D06 PROTN.RELAY-BINARY INPUTS   | 237   | X      | X      | |
| 87B+50BF-1/BU-D06 PROTN.RELAY-BINARY INPUTS   | 238   | X      | X      | |
| CBF-1 & BUSBAR PROTN-1 TRIP RELAY CIRCUIT     | 239   | X      | X      | |
| |
| |
| CONTENTS                                      | ABB<br>SHT.NO.  | REV.00 | REV.01 | REV.02 | |
| COMMON ALARM CIRCUITS                         | 292   | X      | X      | |
| BLOCK REFERENCE 87B+50BF-1/BU-D02             | 293   | X      | X      | |
| BLOCK REFERENCE 87B+50BF-1/BU-D02             | 294   | X      | X      | |
| BLOCK REFERENCE 87B+50BF-1/BU-D04             | 295   | X      | X      | |
| BLOCK REFERENCE 87B+50BF-1/BU-D04             | 296   | X      | X      | |
| BLOCK REFERENCE 87B+50BF-1/BU-D06             | 297   | X      | X      | |
| BLOCK REFERENCE 87B+50BF-1/BU-D06             | 298   | X      | X      | |
| TERMINAL BLOCKS REFERENCE                     | 301   | X      | X      | |
| |
| |
| B   | |
| C   | |
| D   | |
| E   | |
| F   | |

|                              |       |                                 |   |                              |   |                       |  |  |       |           |                |           |          |
|------------------------------|-------|---------------------------------|---|------------------------------|---|-----------------------|--|--|-------|-----------|----------------|-----------|----------|
| AS-BUILT BY _____ DATE _____ |       | CONTRACT NO. <b>11131113/00</b> |   | JOB ORDER NO. <b>S-13656</b> |   | <b>CONTENTS SHEET</b> |  | نقل الكهرباء<br>الشركة الوطنية لنقل الكهرباء<br>National Grid sa |       |           |                |           |          |
| 01                           | 13 49 | FACTORY ASBUILT                 | DRAWN BY <b>RIZ</b>                                 | CHECKED BY <b>KVR</b>        | <b>132KV BUSBAR PROTN.MAIN-1 BU PANEL +88P1-5</b><br><b>S/S 8709 - 132/13.8KV IN AL-KHARJ CITY</b><br><b>RIYADH</b> |                       |  |  | INDEX | PLANT NO. | DRAWING NUMBER | SHEET NO. | REV. NO. |
| 00                           | 13 05 | FOR APPROVAL                    | DATE STARTED <b>28.01.2013</b> DATE COMPLETED _____ |                              |   |                       |  |  | -     | C421      | CD-322999      | SHT       | CONT.    |
| REV. NO.                     | DATE  | DESCRIPTION                     | OPRG. DEPT. <b>CTPD</b> ENG. DEPT. <b>AUT-PSAC</b>  |                              | SAUDI ARABIA  |                       |  |  |       |           |                |           |          |

|   |   |   |   |   |   |   |   |   |    |
|---|---|---|---|---|---|---|---|---|----|
| 1 | 2 | 3 | 4 | 5 | 6 | 7 | 8 | 9 | 10 |
| A |   |   |   |   |   |   |   |   |    |
| B |   |   |   |   |   |   |   |   |    |
| C |   |   |   |   |   |   |   |   |    |
| D |   |   |   |   |   |   |   |   |    |
| E |   |   |   |   |   |   |   |   |    |
| F |   |   |   |   |   |   |   |   |    |
| G |   |   |   |   |   |   |   |   |    |

| SYMBOL | DESCRIPTION   | SYMBOL | DESCRIPTION  | SYMBOL | DESCRIPTION   |
|--------|---|--------|--|--------|---|
|        | FRAME CONNECTION  |        | MAIN CONTACT OF A CIRCUIT BREAKER PASSING MAKE CONTACT CLOSING MOMENTARILY DURING OPERATION AND RELEASE    |        | RELAY WITH TWO MAKE CONTACTS, ONE OF THEM DELAYED WHEN OPERATING                      |
|        | EARTH CONNECTION  |        | BREAK CONTACT DELAYED WHEN OPERATING   |        | RELAY WITH TWO ACTUATORS AND A TWO STABLE POSITIONS                                   |
|        | RESISTOR  |        | MAKE CONTACT DELAYED WHEN RELEASING  |        | TWO MECHANICAL LINKS CROSSING WITHOUT CONNECTION                                      |
|        | VARIABLE RESISTOR   |        | JUNCTION OF MECHANICAL LINKS   |        | AUTOMATIC RESET   |
|        | RESISTOR WITH PRESET ADJUSTMENT                                     |        | NON-AUTOMATIC RESET  |        | MECHANICAL INDICATOR WITH AUTOMATIC RESET   |
|        | CAPACITOR   |        | SWITCHING DEVICE WITH MANUAL OPERATION AND WITH AUTOMATIC RESET  |        | MECHANICAL INDICATOR WITH NON-AUTOMATIC RESET   |
|        | SEMICONDUCTOR DIODE USED AS A CAPACITIVE DEVICE                     |        | SWITCHING DEVICE WITH MANUAL OPERATION AND WITH NON-AUTOMATIC RESET  |        | ELECTRICALLY CONTROLLED MECHANICAL INDICATOR WITH AUTOMATIC RESET                     |
|        | OPEN CONTACT, MAKE CONTACT  |        | CHANGE-OVER SWITCHING DEVICE WITH MANUAL CONTROL AUTOMATIC RESET FROM POSITION 1-2 TO THE NEUTRAL POSITION |        | ELECTRICALLY CONTROLLED MECHANICAL INDICATOR WITH NON-AUTOMATIC RESET                 |
|        | CLOSED CONTACT, BREAK CONTACT                                       |        | RELAY WITH MAKE CONTACT  |        | RELAY WITH MECHANICAL INDICATOR   |
|        | CHANGE-OVER CONTACT, BREAK BEFORE MAKE                              |        | RELAY WITH CHANGE-OVER CONTACT   |        | ELECTRO-MECHANICAL POSITION INDICATOR WITH ONE DE-ENERGIZED AND ONE OPERATED POSITION |
|        | MAKE CONTACT WHICH IS EARLY WHEN OPERATING AND LATE WHEN RELEASING  |        | RELAY WITH MAKE CONTACT, DELAYED WHEN OPERATING  |        | ELECTRO-MECHANICAL POSITION INDICATOR WITH ONE DE-ENERGIZED AND TWO OPERATED POSITION |
|        | BREAK CONTACT WHICH IS LATE WHEN OPERATING AND EARLY WHEN RELEASING |        | RELAY WITH MAKE CONTACT, DELAYED WHEN RELEASING  |        | BELL, BUZZER  |
|        | SWITCHING DEVICE WITH MANUAL CONTROL                                |        | RELAY WITH MAKE CONTACT, DELAYED WHEN OPERATING AND RELEASING  |        | SIREN , HORN  |
|        | MAKE CONTACT DELAYED WHEN OPERATING                                 |        |  |        |   |
|        | BREAK CONTACT DELAYED WHEN RELEASING                                |        |  |        |   |
|        | MAKE CONTACT DELAYED WHEN OPERATING AND RELEASING                   |        |  |        |   |
|        | MAIN CONTACT OF A SWITCH DISCONNECTOR                               |        |  |        |   |
|        | MAIN CONTACT OF A DISCONNECTOR                                      |        |  |        |   |

|                                     |  |  |  |  |  |  |  |                              |  |
|-------------------------------------|--|--|--|--|--|--|--|------------------------------|--|
| AS-BUILT BY _____ DATE _____        |  | CONTRACT NO. 11131113/00                     |  | JOB ORDER NO. S-13656                      |  | GRAPHICAL SYMBOLS FOR DIAGRAMS         |  | الشركة الوطنية لنقل الكهرباء |  |
| DRAWN BY RIZ CHECKED BY KVR         |  | DATE STARTED 28.01.2013 DATE COMPLETED _____ |  | 132KV BUSBAR PROTN.MAIN-1 BU PANEL +8BP1-5 |  | S/S 8709 - 132/13.8KV IN AL-KHARJ CITY |  | National Grid sa             |  |
| PRG. DEPT. CTPD ENG. DEPT. AUT-PSAC |  | R/ADH SAUDI ARABIA                           |  | INDEX -                                    |  | PLANT NO. C421                         |  | DRAWING NUMBER CD-322999     |  |
| REV. NO. 00                         |  | DATE 13 05                                   |  | DESCRIPTION                                |  | SHT 011                                |  | CONT. 012                    |  |



|  | 1   | 2               | 3   | 4      | 5  | 6 | 7  | 8 | 9                            | 10        | |
|---|
| A  | |
| B  | |
| C  | |
| D  | |
| E  | |
| F  | |
| <table><tr><th>SYMBOL</th><th>DESCRIPTION</th><th>SYMBOL</th><th>DESCRIPTION</th><th>SYMBOL</th><th>DESCRIPTION</th></tr><tr><td></td><td>FUSE / LINK</td><td></td><td>WATTMETER</td><td></td><td>ELEMENT WITH NEGATED INHIBITING INPUT</td></tr><tr><td></td><td>FUSE WITH THE SUPPLY SIDE INDICATED</td><td></td><td>VARMETER</td><td></td><td>ELEMENT WITH INPUT WHICH DOES NOT CARRY ANY LOGIC INFORMATION</td></tr><tr><td></td><td rowspan="2">SINGLE-PHASE TRANSFORMER WITH TWO SEPARATE WINDINGS (TWO ALTERNATIVE FORMS)</td><td></td><td>POWER FACTOR METER</td><td></td><td>ELEMENT WITH POSTPONED OUTPUT</td></tr><tr><td></td><td></td><td>POSITION INDICATOR</td><td></td><td>AND-ELEMENT WITH TWO INPUTS</td></tr><tr><td></td><td>SINGLE-PHASE TRANSFORMER WITH FERRO MAGNETIC CORE</td><td></td><td>SYNCHROSCOPE</td><td></td><td>OR-ELEMENT WITH TWO INPUTS</td></tr><tr><td></td><td rowspan="2">SINGLE-PHASE VOLTAGE TRANSFORMER (MULTI-LINE AND SINGLE-LINE REPRESENTATION)</td><td></td><td>RECORDING VOLTMETER</td><td></td><td>LOGIC THRESHOLD ELEMENT WITH FOUR INPUTS AND THRESHOLD VALUE 2</td></tr><tr><td></td><td></td><td>RECORDING WATTMETER</td><td></td><td>ELEMENT WITH THREE INPUTS FOR "2 AND ONLY 2"</td></tr><tr><td></td><td>CURRENT TRANSFORMER (MULTI-LINE AND SINGLE-LINE REPRESENTATION)</td><td></td><td>HOUR METER</td><td></td><td>EXCLUSIVE OR-ELEMENT WITH THREE INPUTS</td></tr><tr><td></td><td rowspan="2">CURRENT TRANSFORMER WITH TWO CORES (MULTI-LINE AND SINGLE-LINE REPRESENTATION)</td><td></td><td>WATT-HOUR METER</td><td></td><td>LOGIC IDENTITY ELEMENT WITH THREE INPUTS</td></tr><tr><td></td><td></td><td>WATT-HOUR METER FOR ENERGY FROM A BUSBAR SYSTEM</td><td></td><td>MAJORITY ELEMENT WITH THREE INPUTS</td></tr><tr><td></td><td>CURRENT TRANSFORMER WITH TWO SECONDARY WINDINGS ON ONE CORE (MULTI-LINE AND SINGLE-LINE REPRESENTATION)</td><td></td><td>ELEMENT WITH STATIC INPUT</td><td></td><td>NEGATOR</td></tr><tr><td></td><td>FILTER</td><td></td><td>ELEMENT WITH STATIC NEGATED INPUT</td><td></td><td>NAND ELEMENT WITH TWO INPUTS</td></tr><tr><td></td><td>HIGH-PASS FILTER</td><td></td><td>ELEMENT WITH STATIC NEGATED OUTPUT</td><td></td><td>NOR ELEMENT WITH TWO INPUTS</td></tr><tr><td></td><td>BAND-PASS FILTER</td><td></td><td>ELEMENT WITH DYNAMIC INPUT</td><td></td><td>BISTABLE ELEMENT</td></tr><tr><td></td><td>VOLTMETER</td><td></td><td>ELEMENT WITH DYNAMIC NEGATED INPUT</td><td></td><td></td></tr><tr><td></td><td>AMMETER</td><td></td><td>ELEMENT WITH INHIBITING INPUT</td><td></td><td></td></tr></table> |   |                 |   |        |  |   |  |   |                              |           | SYMBOL                       | DESCRIPTION | SYMBOL | DESCRIPTION              | SYMBOL | DESCRIPTION           |  | FUSE / LINK                    |  | WATTMETER                    |  | ELEMENT WITH NEGATED INHIBITING INPUT |       | FUSE WITH THE SUPPLY SIDE INDICATED |              | VARMETER |                | ELEMENT WITH INPUT WHICH DOES NOT CARRY ANY LOGIC INFORMATION |  | SINGLE-PHASE TRANSFORMER WITH TWO SEPARATE WINDINGS (TWO ALTERNATIVE FORMS) |                  | POWER FACTOR METER |    | ELEMENT WITH POSTPONED OUTPUT |              |                         | POSITION INDICATOR |                      | AND-ELEMENT WITH TWO INPUTS |  | SINGLE-PHASE TRANSFORMER WITH FERRO MAGNETIC CORE |       | SYNCHROSCOPE |          | OR-ELEMENT WITH TWO INPUTS |             | SINGLE-PHASE VOLTAGE TRANSFORMER (MULTI-LINE AND SINGLE-LINE REPRESENTATION) |  | RECORDING VOLTMETER |  | LOGIC THRESHOLD ELEMENT WITH FOUR INPUTS AND THRESHOLD VALUE 2 |  |   | RECORDING WATTMETER |  | ELEMENT WITH THREE INPUTS FOR "2 AND ONLY 2" |  | CURRENT TRANSFORMER (MULTI-LINE AND SINGLE-LINE REPRESENTATION) |  | HOUR METER |  | EXCLUSIVE OR-ELEMENT WITH THREE INPUTS |  | CURRENT TRANSFORMER WITH TWO CORES (MULTI-LINE AND SINGLE-LINE REPRESENTATION) |  | WATT-HOUR METER |  | LOGIC IDENTITY ELEMENT WITH THREE INPUTS |  |  | WATT-HOUR METER FOR ENERGY FROM A BUSBAR SYSTEM |  | MAJORITY ELEMENT WITH THREE INPUTS |  | CURRENT TRANSFORMER WITH TWO SECONDARY WINDINGS ON ONE CORE (MULTI-LINE AND SINGLE-LINE REPRESENTATION) |  | ELEMENT WITH STATIC INPUT |  | NEGATOR |  | FILTER |  | ELEMENT WITH STATIC NEGATED INPUT |  | NAND ELEMENT WITH TWO INPUTS |           | HIGH-PASS FILTER |  | ELEMENT WITH STATIC NEGATED OUTPUT |  | NOR ELEMENT WITH TWO INPUTS |  | BAND-PASS FILTER |  | ELEMENT WITH DYNAMIC INPUT |  | BISTABLE ELEMENT |    | VOLTMETER |  | ELEMENT WITH DYNAMIC NEGATED INPUT |  |  |  | AMMETER |  | ELEMENT WITH INHIBITING INPUT |  |  |
| SYMBOL   | DESCRIPTION   | SYMBOL          | DESCRIPTION                                     | SYMBOL | DESCRIPTION  | |
|  | FUSE / LINK   |                 | WATTMETER                                       |        | ELEMENT WITH NEGATED INHIBITING INPUT                          | |
|  | FUSE WITH THE SUPPLY SIDE INDICATED   |                 | VARMETER  |        | ELEMENT WITH INPUT WHICH DOES NOT CARRY ANY LOGIC INFORMATION  | |
|  | SINGLE-PHASE TRANSFORMER WITH TWO SEPARATE WINDINGS (TWO ALTERNATIVE FORMS)   |                 | POWER FACTOR METER                              |        | ELEMENT WITH POSTPONED OUTPUT                                  | |
|  |   |                 | POSITION INDICATOR                              |        | AND-ELEMENT WITH TWO INPUTS                                    | |
|  | SINGLE-PHASE TRANSFORMER WITH FERRO MAGNETIC CORE   |                 | SYNCHROSCOPE                                    |        | OR-ELEMENT WITH TWO INPUTS                                     | |
|  | SINGLE-PHASE VOLTAGE TRANSFORMER (MULTI-LINE AND SINGLE-LINE REPRESENTATION)  |                 | RECORDING VOLTMETER                             |        | LOGIC THRESHOLD ELEMENT WITH FOUR INPUTS AND THRESHOLD VALUE 2 | |
|  |   |                 | RECORDING WATTMETER                             |        | ELEMENT WITH THREE INPUTS FOR "2 AND ONLY 2"                   | |
|  | CURRENT TRANSFORMER (MULTI-LINE AND SINGLE-LINE REPRESENTATION)   |                 | HOUR METER                                      |        | EXCLUSIVE OR-ELEMENT WITH THREE INPUTS                         | |
|  | CURRENT TRANSFORMER WITH TWO CORES (MULTI-LINE AND SINGLE-LINE REPRESENTATION)  |                 | WATT-HOUR METER                                 |        | LOGIC IDENTITY ELEMENT WITH THREE INPUTS                       | |
|  |   |                 | WATT-HOUR METER FOR ENERGY FROM A BUSBAR SYSTEM |        | MAJORITY ELEMENT WITH THREE INPUTS                             | |
|  | CURRENT TRANSFORMER WITH TWO SECONDARY WINDINGS ON ONE CORE (MULTI-LINE AND SINGLE-LINE REPRESENTATION)   |                 | ELEMENT WITH STATIC INPUT                       |        | NEGATOR  | |
|  | FILTER  |                 | ELEMENT WITH STATIC NEGATED INPUT               |        | NAND ELEMENT WITH TWO INPUTS                                   | |
|  | HIGH-PASS FILTER  |                 | ELEMENT WITH STATIC NEGATED OUTPUT              |        | NOR ELEMENT WITH TWO INPUTS                                    | |
|  | BAND-PASS FILTER  |                 | ELEMENT WITH DYNAMIC INPUT                      |        | BISTABLE ELEMENT   | |
|  | VOLTMETER   |                 | ELEMENT WITH DYNAMIC NEGATED INPUT              | |
|  | AMMETER   |                 | ELEMENT WITH INHIBITING INPUT                   | |
| G  | <table><tr><td colspan="3">AS-BUILT BY _____ DATE _____</td><td colspan="2">CONTRACT NO. 11131113/00</td><td colspan="2">JOB ORDER NO. S-13656</td><td colspan="2">GRAPHICAL SYMBOLS FOR DIAGRAMS</td><td colspan="2">الشركة الوطنية لنقل الكهرباء</td></tr><tr><td>01</td><td>13 49</td><td>FACTORY ASBUILT</td><td colspan="2">DRAWN BY RIZ</td><td colspan="2">CHECKED BY KVR</td><td colspan="2">132KV BUSBAR PROTN.MAIN-1 BU PANEL +BBPI-5</td><td colspan="2">National Grid sa</td></tr><tr><td>00</td><td>13 05</td><td>FOR APPROVAL</td><td colspan="2">DATE STARTED 28.01.2013</td><td colspan="2">DATE COMPLETED _____</td><td colspan="2">S/S 8709 - 132/13.8KV IN AL-KHARJ CITY</td><td>INDEX</td><td>PLANT NO.</td></tr><tr><td>REV. NO.</td><td>DATE</td><td>DESCRIPTION</td><td colspan="2">OPRG. DEPT. CTPD</td><td colspan="2">ENG. DEPT. AUT-PSAC</td><td colspan="2">RIYADH SAUDI ARABIA</td><td>-</td><td>C421</td></tr><tr><td colspan="9"></td><td colspan="2">DRAWING NUMBER</td></tr><tr><td colspan="9"></td><td colspan="2">CD-322999</td></tr><tr><td colspan="9"></td><td>SHEET NO.</td><td>REV. NO.</td></tr><tr><td colspan="9"></td><td>012 013</td><td>01</td></tr></table> |                 |   |        |  |   |  |   |                              |           | AS-BUILT BY _____ DATE _____ |             |        | CONTRACT NO. 11131113/00 |        | JOB ORDER NO. S-13656 |  | GRAPHICAL SYMBOLS FOR DIAGRAMS |  | الشركة الوطنية لنقل الكهرباء |  | 01                                    | 13 49 | FACTORY ASBUILT                     | DRAWN BY RIZ |          | CHECKED BY KVR |   | 132KV BUSBAR PROTN.MAIN-1 BU PANEL +BBPI-5 |   | National Grid sa |                    | 00 | 13 05                         | FOR APPROVAL | DATE STARTED 28.01.2013 |                    | DATE COMPLETED _____ |                             | S/S 8709 - 132/13.8KV IN AL-KHARJ CITY |   | INDEX | PLANT NO.    | REV. NO. | DATE                       | DESCRIPTION | OPRG. DEPT. CTPD   |  | ENG. DEPT. AUT-PSAC |  | RIYADH SAUDI ARABIA  |  | - | C421                |  |  |  |   |  |            |  |  |  | DRAWING NUMBER   |  |                 |  |  |  |  |   |  |                                    |  | CD-322999   |  |                           |  |         |  |        |  |                                   |  |                              | SHEET NO. | REV. NO.         |  |                                    |  |                             |  |                  |  |                            |  | 012 013          | 01 |           |  |                                    |  |  |  |         |  |                               |  |  |
| AS-BUILT BY _____ DATE _____   |   |                 | CONTRACT NO. 11131113/00                        |        | JOB ORDER NO. S-13656  |   | GRAPHICAL SYMBOLS FOR DIAGRAMS             |   | الشركة الوطنية لنقل الكهرباء | |
| 01   | 13 49   | FACTORY ASBUILT | DRAWN BY RIZ                                    |        | CHECKED BY KVR   |   | 132KV BUSBAR PROTN.MAIN-1 BU PANEL +BBPI-5 |   | National Grid sa             | |
| 00   | 13 05   | FOR APPROVAL    | DATE STARTED 28.01.2013                         |        | DATE COMPLETED _____   |   | S/S 8709 - 132/13.8KV IN AL-KHARJ CITY     |   | INDEX                        | PLANT NO. | |
| REV. NO.   | DATE  | DESCRIPTION     | OPRG. DEPT. CTPD                                |        | ENG. DEPT. AUT-PSAC  |   | RIYADH SAUDI ARABIA                        |   | -                            | C421      | |
|  |   |                 |   |        |  |   |  |   | DRAWING NUMBER               | |
|  |   |                 |   |        |  |   |  |   | CD-322999                    | |
|  |   |                 |   |        |  |   |  |   | SHEET NO.                    | REV. NO.  | |
|  |   |                 |   |        |  |   |  |   | 012 013                      | 01        | |

THIS DRAWING AND THE INFORMATION CONTAINED HEREIN ARE THE SOLE PROPERTY OF NATIONAL GRID SA. NO REPRODUCTION IN FULL OR IN PART SHALL BE OBTAINED FROM THIS DOCUMENT WITHOUT THE WRITTEN CONSENT OF ITS OWNER.

|   |   |   |   |   |   |   |   |   |   |    |
|---|---|---|---|---|---|---|---|---|---|----|
|   | 1 | 2 | 3 | 4 | 5 | 6 | 7 | 8 | 9 | 10 |
| A |   |   |   |   |   |   |   |   |   |    |
| B |   |   |   |   |   |   |   |   |   |    |
| C |   |   |   |   |   |   |   |   |   |    |
| D |   |   |   |   |   |   |   |   |   |    |
| E |   |   |   |   |   |   |   |   |   |    |
| F |   |   |   |   |   |   |   |   |   |    |

### LEGENDS

|              |  |
|--------------|--|
| ±R1          | DC SUPPLY - MAIN PROTECTION            |
| ±R2          | DC SUPPLY - SECONDARY PROTECTION       |
| ±R3          | DC SUPPLY - BACK UP PROTECTION         |
| ±IT          | DC SUPPLY - INTER TRIP                 |
| FL           | DC SUPPLY - FLASHING CIRCUIT           |
| BB RS±       | DC SUPPLY - BUS BAR - PROTECTION RESET |
| BB CBF±/CBF± | DC SUPPLY - CBF PROTECTION             |
|              |  |
| R            | RESET BUS - ALARM SYSTEM               |
| CR           | CONTROL ROOM                           |
| ECC          | ENERGY CONTROL CENTRE                  |
| LOCAL        | THE LOCATION OF CONTROLLED DEVICE      |
| REMOTE       | ANY OTHER LOCATION NOT LOCAL           |
|              |  |
| ON           | CB NORMALLY OPEN AUXILIARY CONTACT     |
| OFF          | CB NORMALLY CLOSED AUXILIARY CONTACT   |
| A            | COMMON                                 |
| T            | TEST POSITION                          |
| S            | SERVICE POSITION                       |
| CS           | CLOSE IN SERVICE POSITION              |
| CT           | CLOSE IN TEST POSITION                 |
| LS           | LOCAL SERVICE                          |
| LT           | LOCAL TEST                             |
| LC           | LOCAL CLOSE                            |
| LO           | LOCAL OPEN                             |
| RO           | REMOTE OPEN                            |
| OP           | OPERATE                                |
| RE           | RESET                                  |

### NOTES

#### LABELS

WHITE LABEL WITH BLACK LETTERING WILL BE PROVIDED FOR ALL MOUNTED APPARATUS EQUIPMENT IDENTIFICATION AND FUNCTION REFERENCE LABEL WILL BE PROVIDED FOR FRONT MOUNTED EQUIPMENTS OF THE PANEL AND EQUIPMENT IDENTIFICATION LABEL WILL BE PROVIDED FOR INTERNALLY MOUNTED EQUIPMENTS

#### WIRING

PVC INSULATED 600V GRADE  
2.5 SQ.mm. YELLOW COLOURED FOR CT CIRCUITS  
2.5 SQ.mm. RE COLOURED FOR VT CIRCUITS  
1.5 SQ.mm. GREY COLOURED FOR DC SUPPLY, SCADA AND CONTROL CIRCUITS  
2.5 SQ.mm. BLACK COLOURED FOR AVC AND AC CIRCUITS  
2.5 SQ.mm. YELLOW/GREEN COLOURED FOR EARTHING CONNECTIONS  
FOLLOWING MARKERS SHALL BE PROVIDED ON FOLLOWING WIRES:  
+ SIGN FOR DC + WIRE  
- SIGN FOR DC - WIRE


#### LUGS

A. CT CIRCUITS- RING TYPE  
B. OTHER CIRCUITS - SPADE TYPE

#### FERULLING

YELLO TUBE 3.2 mm FOR 1.5SQ mm WIRES AND 4.2 FOR 2.5 SQ mm WIRES  
( AS PER 31 - TMSS-1, RE.0 )

|                              |       |                                 |   |                              |   |                      |       |  |  |
|------------------------------|-------|---------------------------------|---|------------------------------|---|----------------------|-------|--|--|
| AS-BUILT BY _____ DATE _____ |       | CONTRACT NO. <b>11131113/00</b> |   | JOB ORDER NO. <b>S-13656</b> |   | <b>COMMON LEGEND</b> |       | <b>الشركة الوطنية لنقل الكهرباء</b><br><br><b>نقل الكهرباء</b><br>National Grid sa |  |
| 01                           | 13 49 | FACTORY ASBUILT                 | DRAWN BY <b>RIZ</b>                                 | CHECKED BY <b>KVR</b>        | 132KV BUSBAR PROT.N.MAIN-1 BU PANEL +8BP1-5 |                      | INDEX | PLANT NO.  | DRAWING NUMBER                               |
| 00                           | 13 05 | FOR APPROVAL                    | DATE STARTED <b>28.01.2013</b> DATE COMPLETED _____ |                              | S/S 8709 - 132/13.8KV IN AL-KHARJ CITY      |                      | -     | C421   | CD-322999                                    |
| REV. NO.                     | DATE  | DESCRIPTION                     | OPRG. DEPT. <b>CTPD</b> ENG. DEPT. <b>AUT-PSAC</b>  |                              | RIYADH SAUDI ARABIA                         |                      |       |  |  |
|                              |       |                                 |   |                              |   |                      |       |  | SHEET NO.<br>013 CONT.<br>014 REV. NO.<br>01 |

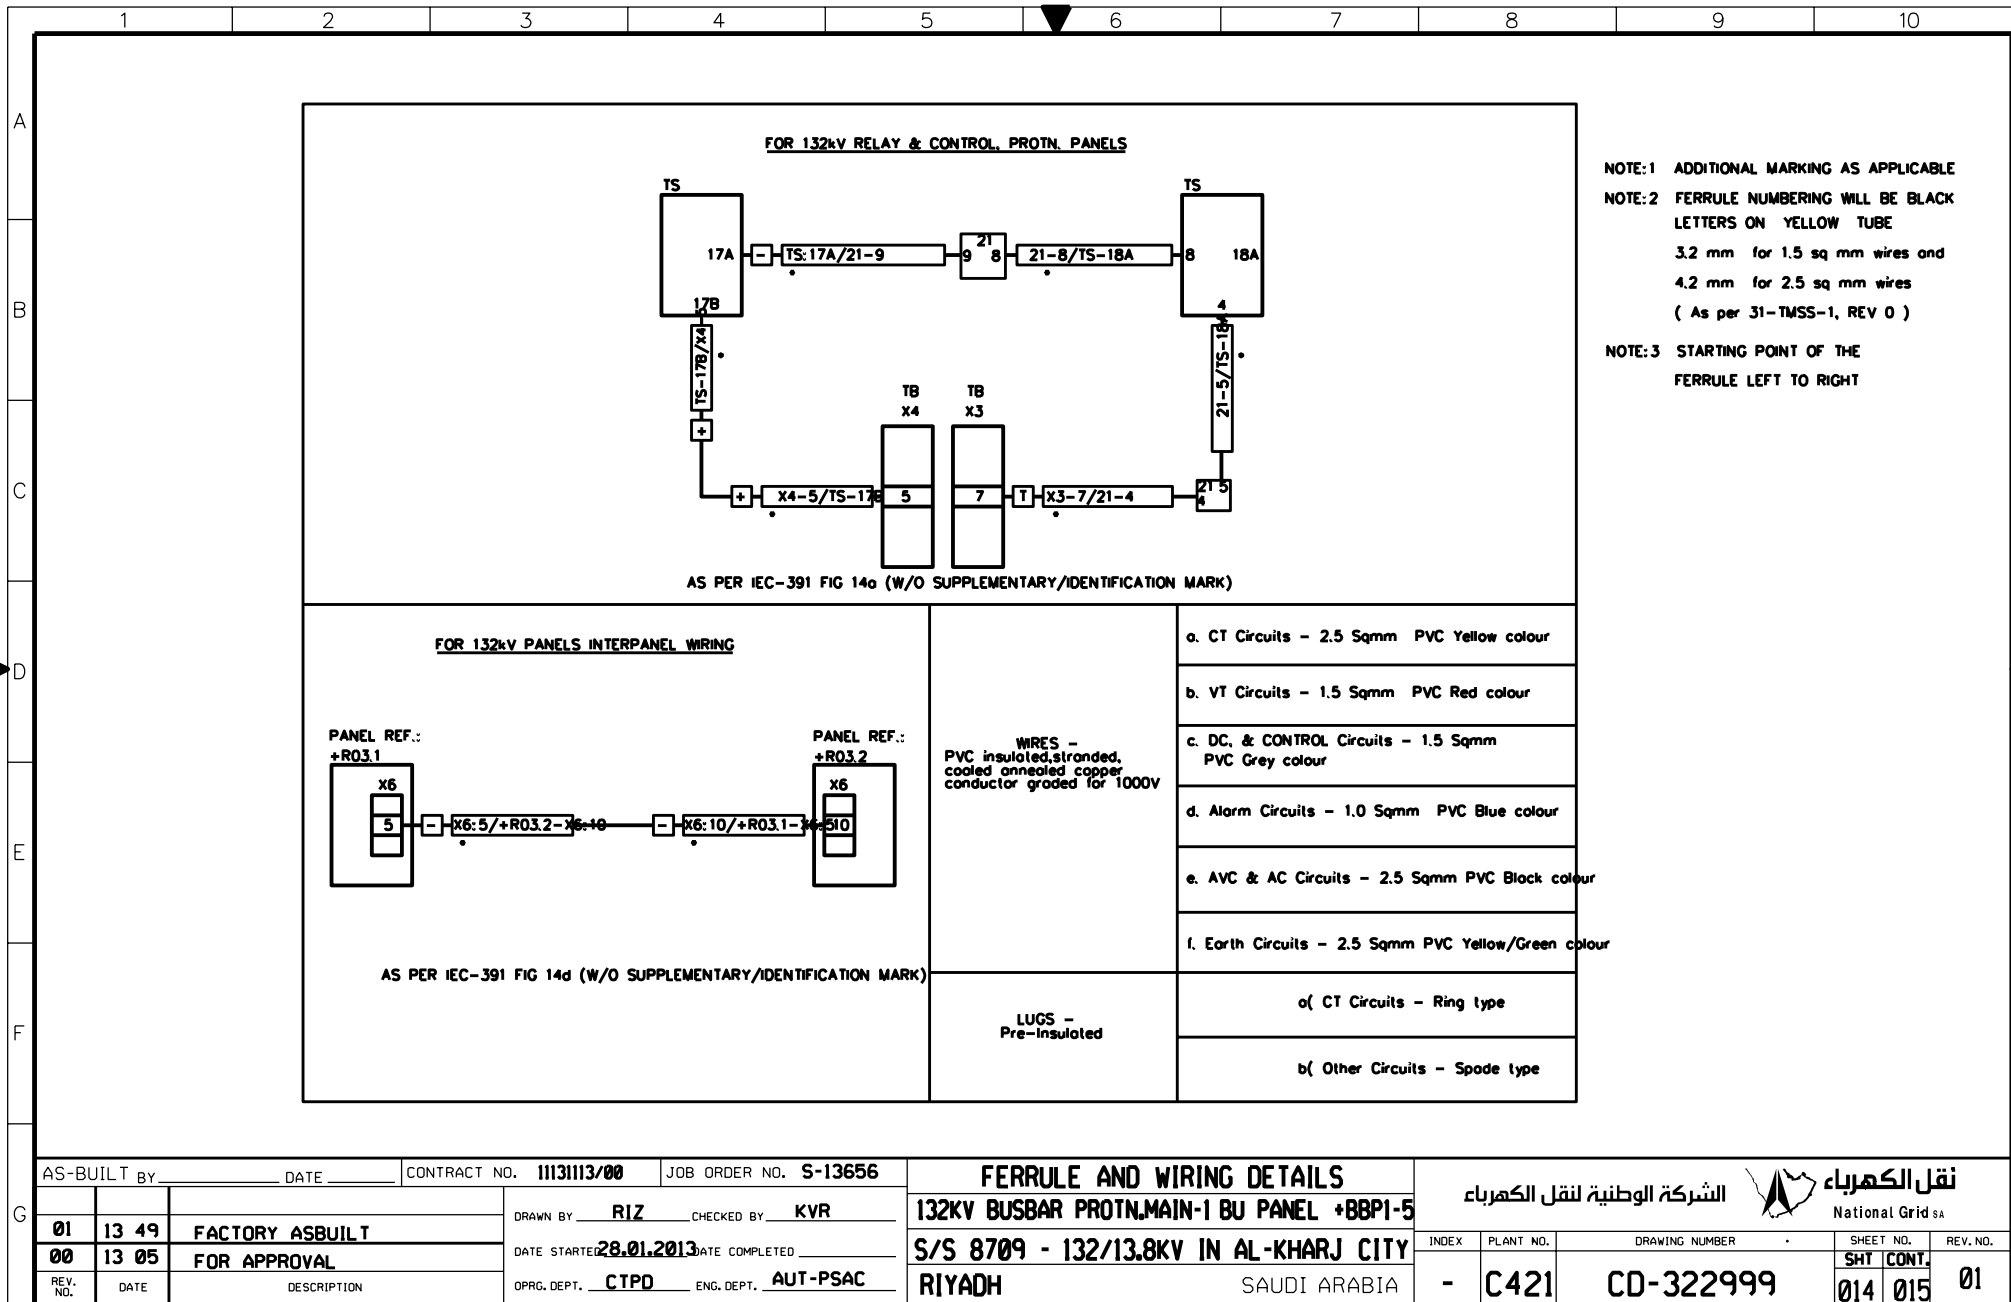











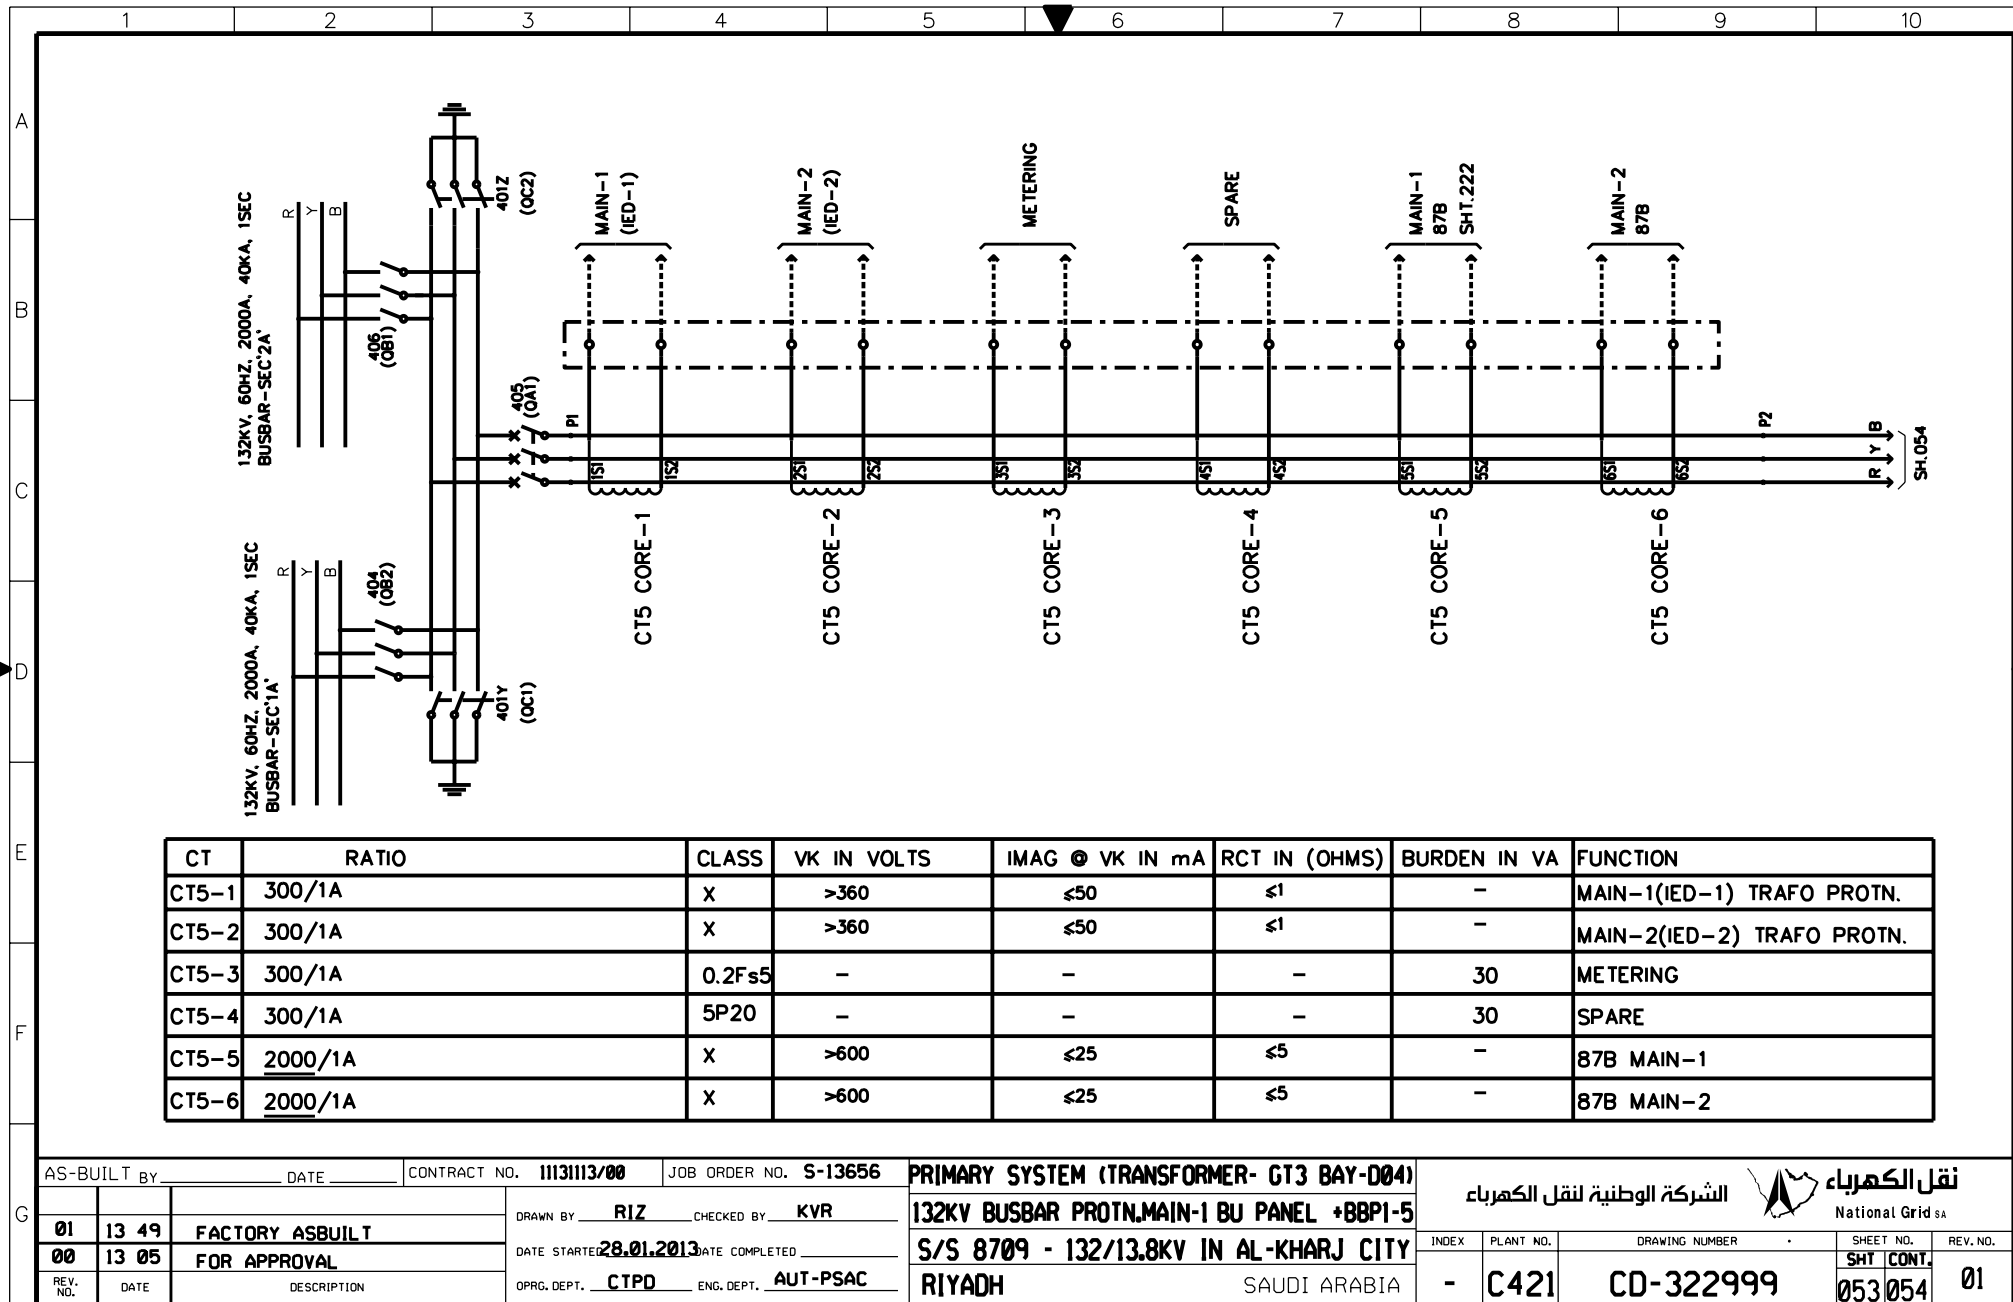


THIS DRAWING AND THE INFORMATION CONTAINED HEREIN ARE THE SOLE PROPERTY OF NATIONAL GRID SA. NO REPRODUCTION IN FULL OR IN PART SHALL BE OBTAINED FROM THIS DOCUMENT WITHOUT THE WRITTEN CONSENT OF ITS OWNER.



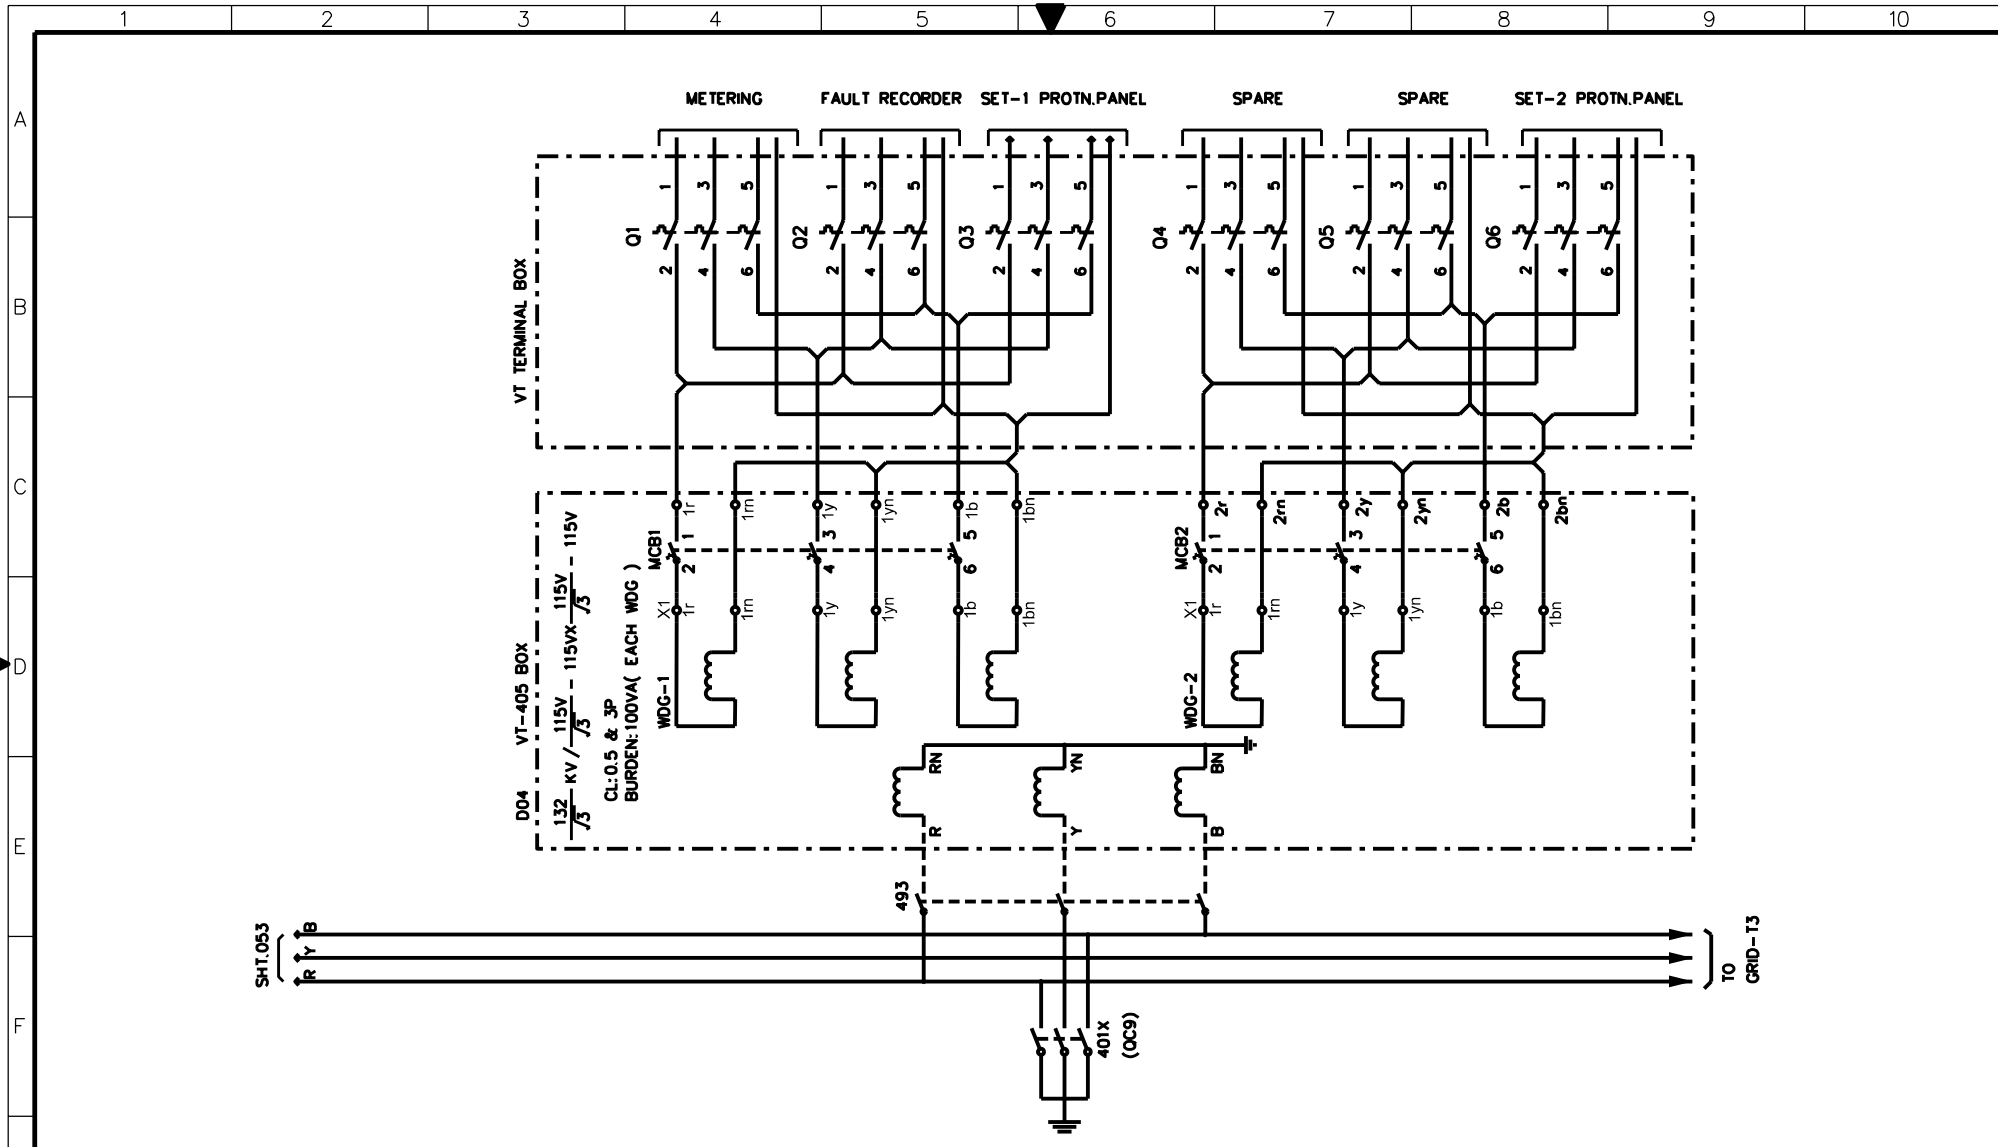


|  |  |  |  |  |                       |  |   |  |                   |  |  |  |
|--|--|--|--|--|-----------------------|--|---|--|-------------------|--|--|--|
| AS-BUILT BY _____ DATE _____                 |  |  | CONTRACT NO. 11131113/00                   |  | JOB ORDER NO. S-13656 |  | PRIMARY SYSTEM (TRANSFORMER- GT3 BAY-D04) |  |                   |  |  |  |
| DRAWN BY RIZ CHECKED BY KVR                  |  |  | 132KV BUSBAR PROTN.MAIN-1 BU PANEL +BBP1-5 |  |                       |  | S/S 8709 - 132/13.8KV IN AL-KHARJ CITY    |  |                   |  |  |  |
| DATE STARTED 28.01.2013 DATE COMPLETED _____ |  |  | RIYADH                                     |  |                       |  | SAUDI ARABIA                              |  |                   |  |  |  |
| OPRG. DEPT. CTPD ENG. DEPT. AUT-PSAC         |  |  | INDEX -                                    |  | PLANT NO. C421        |  | DRAWING NUMBER CD-322999                  |  | SHEET NO. 054/055 |  |  |  |
| REV. NO. 00                                  |  |  | DATE 13 05                                 |  | DESCRIPTION           |  | FACTORY ASBUILT                           |  | FOR APPROVAL      |  |  |  |
| REV. NO. 01                                  |  |  | DATE 13 05                                 |  | DESCRIPTION           |  | FACTORY ASBUILT                           |  | FOR APPROVAL      |  |  |  |




THIS DRAWING AND THE INFORMATION CONTAINED HEREIN ARE THE SOLE PROPERTY OF NATIONAL GRID SA. NO REPRODUCTION IN FULL OR IN PART SHALL BE OBTAINED FROM THIS DOCUMENT WITHOUT THE WRITTEN CONSENT OF ITS OWNER.

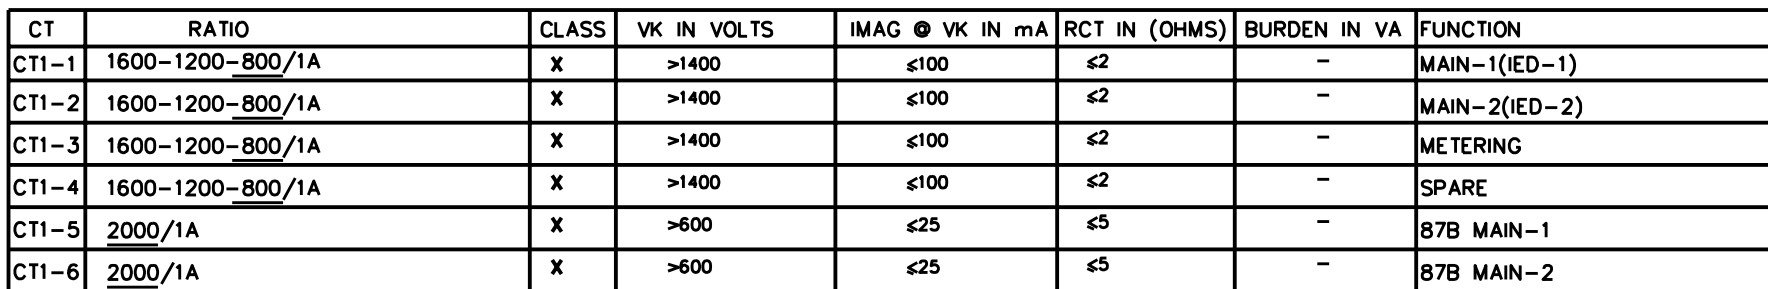

|                              |           |  |                                   |          |
|------------------------------|-----------|--|-----------------------------------|----------|
| الشركة الوطنية لنقل الكهرباء |           |  نقل الكهرباء<br>National Grid SA |                                   |          |
| DEX                          | PLANT NO. | DRAWING NUMBER   | SHEET NO.<br>SHT CONT.<br>055 056 | REV. NO. |
| -                            | C421      | CD-322999  |                                   | 01       |

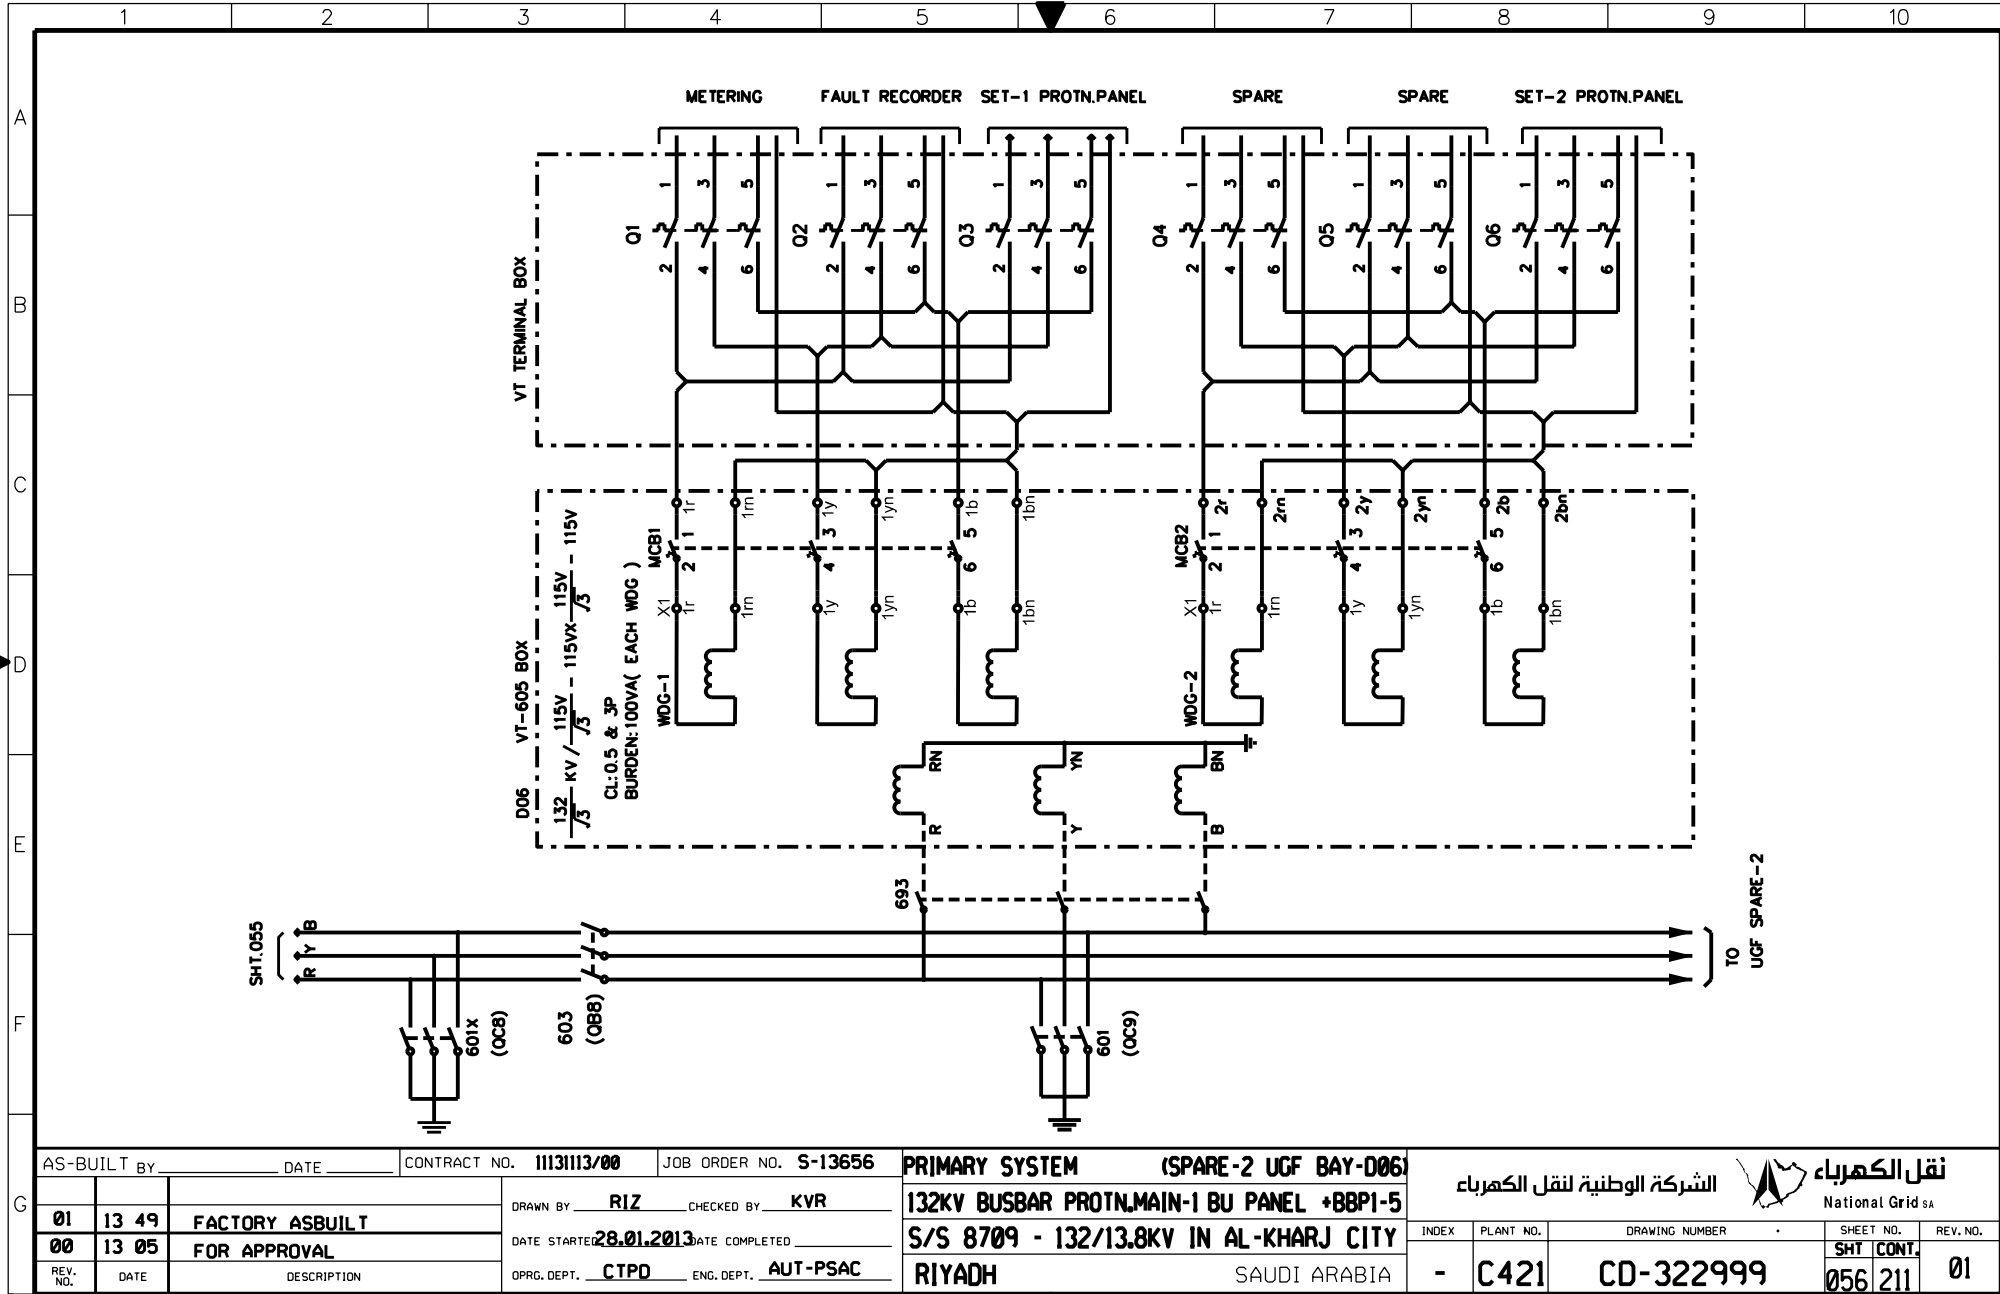

THIS DRAWING AND THE INFORMATION CONTAINED HEREIN ARE THE SOLE PROPERTY OF NATIONAL GRID SA. NO REPRODUCTION IN FULL OR IN PART SHALL BE OBTAINED FROM THIS DOCUMENT WITHOUT THE WRITTEN CONSENT OF ITS OWNER.

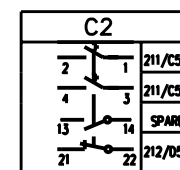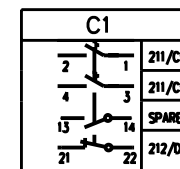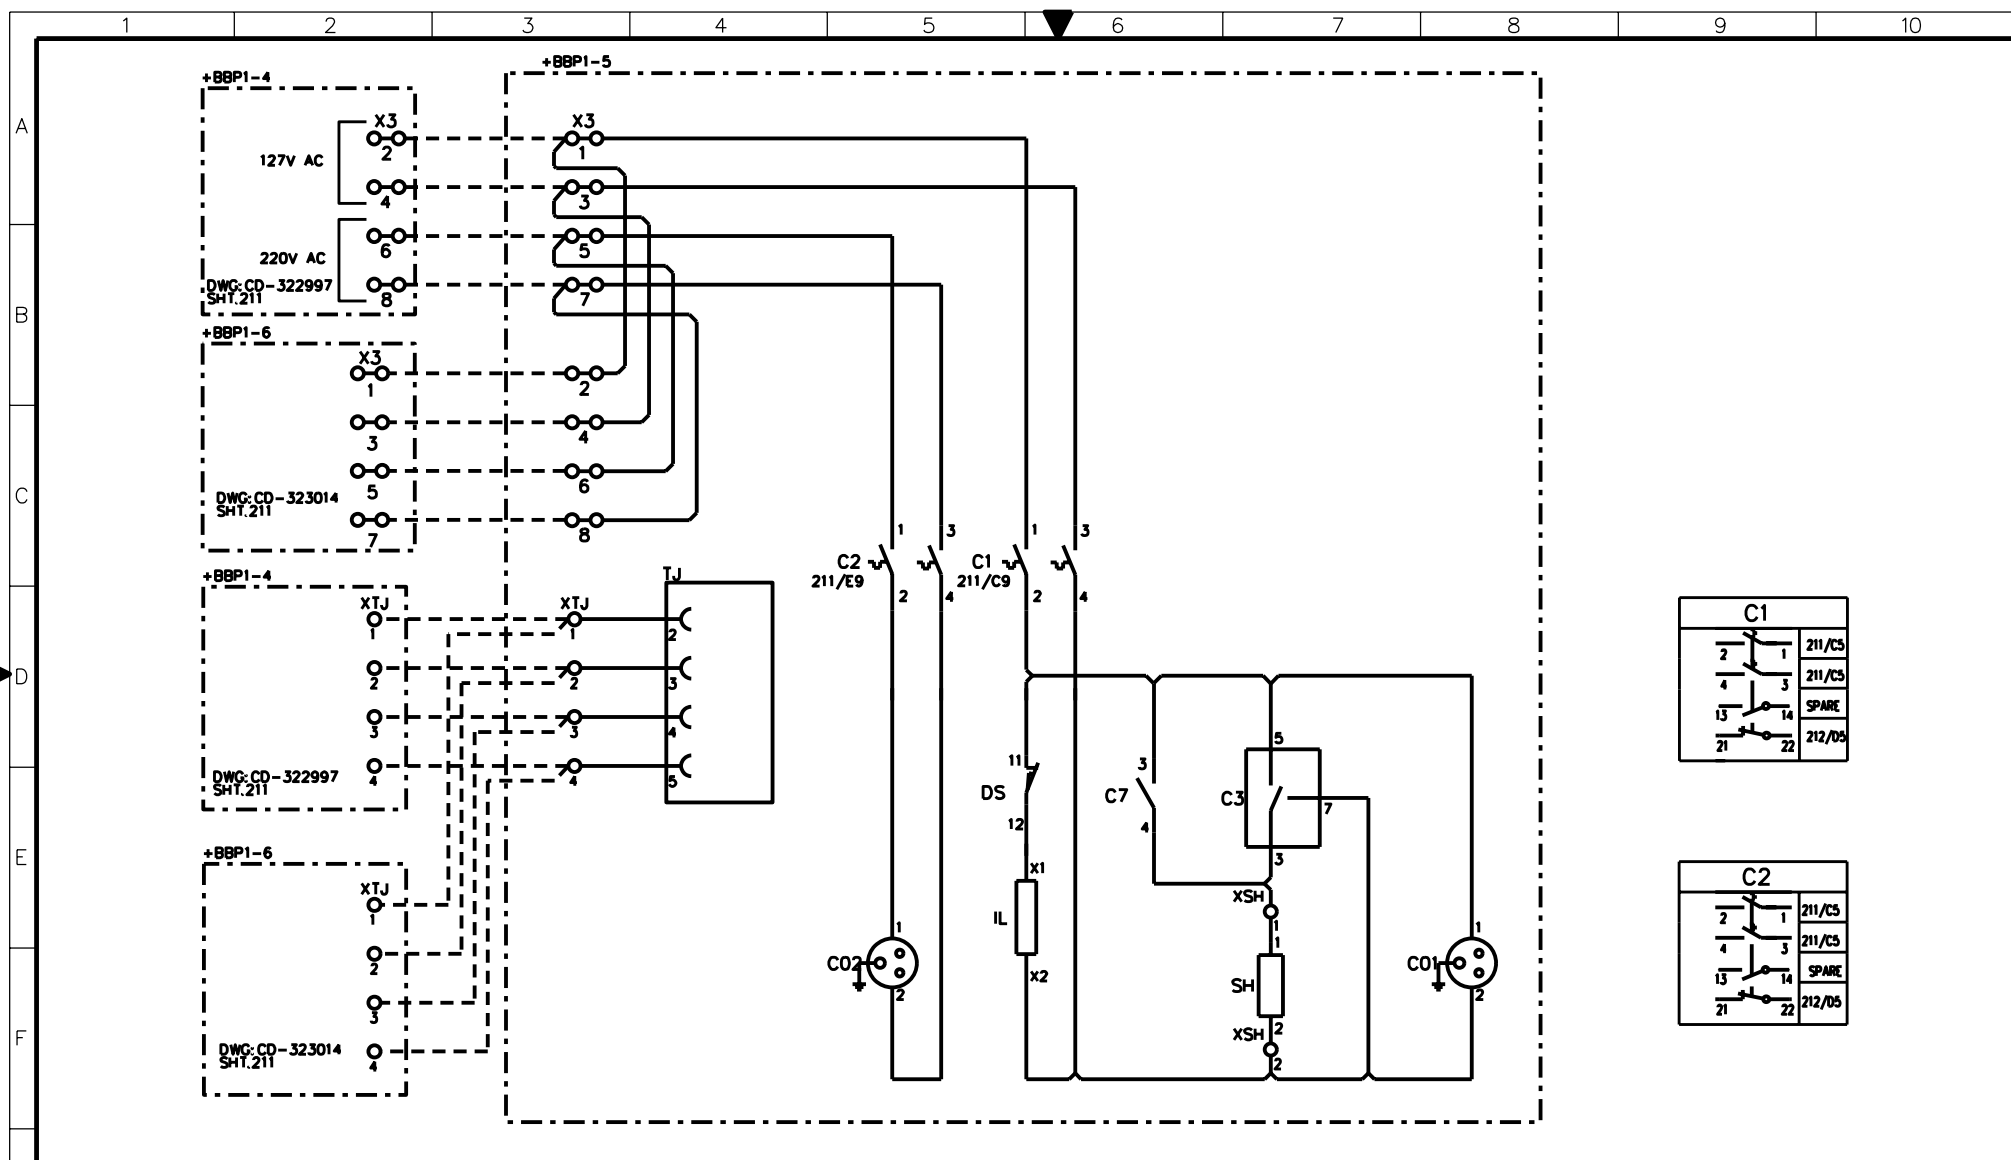


AS-BUILT BY \_\_\_\_\_ DATE \_\_\_\_\_ CONTRACT NO. **11131113/00** JOB ORDER NO. **S-13656**

|          |       |                 |
|----------|-------|-----------------|
| 01       | 13 49 | FACTORY ASBUILT |
| 00       | 13 05 | FOR APPROVAL    |
| REV. NO. | DATE  | DESCRIPTION     |


|                                |                            |
|--------------------------------|----------------------------|
| DRAWN BY <b>RIZ</b>            | CHECKED BY <b>KVR</b>      |
| DATE STARTED <b>28.01.2013</b> | DATE COMPLETED             |
| OPRG. DEPT. <b>CTPD</b>        | ENG. DEPT. <b>AUT-PSAC</b> |

**AC SUPPLY FOR ILLUMINATION & POWER SOCKET**  
**132KV BUSBAR PROTN. MAIN-1 BU PANEL +BBP1-5**  
**S/S 8709 - 132/13.8KV IN AL-KHARJ CITY**  
**RIYADH SAUDI ARABIA**


|                              |           |                |           |
|------------------------------|-----------|----------------|-----------|
| الشركة الوطنية لنقل الكهرباء |           | نقل الكهرباء   |           |
| National Grid sa             |           |                |           |
| INDEX                        | PLANT NO. | DRAWING NUMBER | SHEET NO. |
| -                            | C421      | CD-322999      | 211 212   |
|                              |           |                | REV. NO.  |
|                              |           |                | 01        |

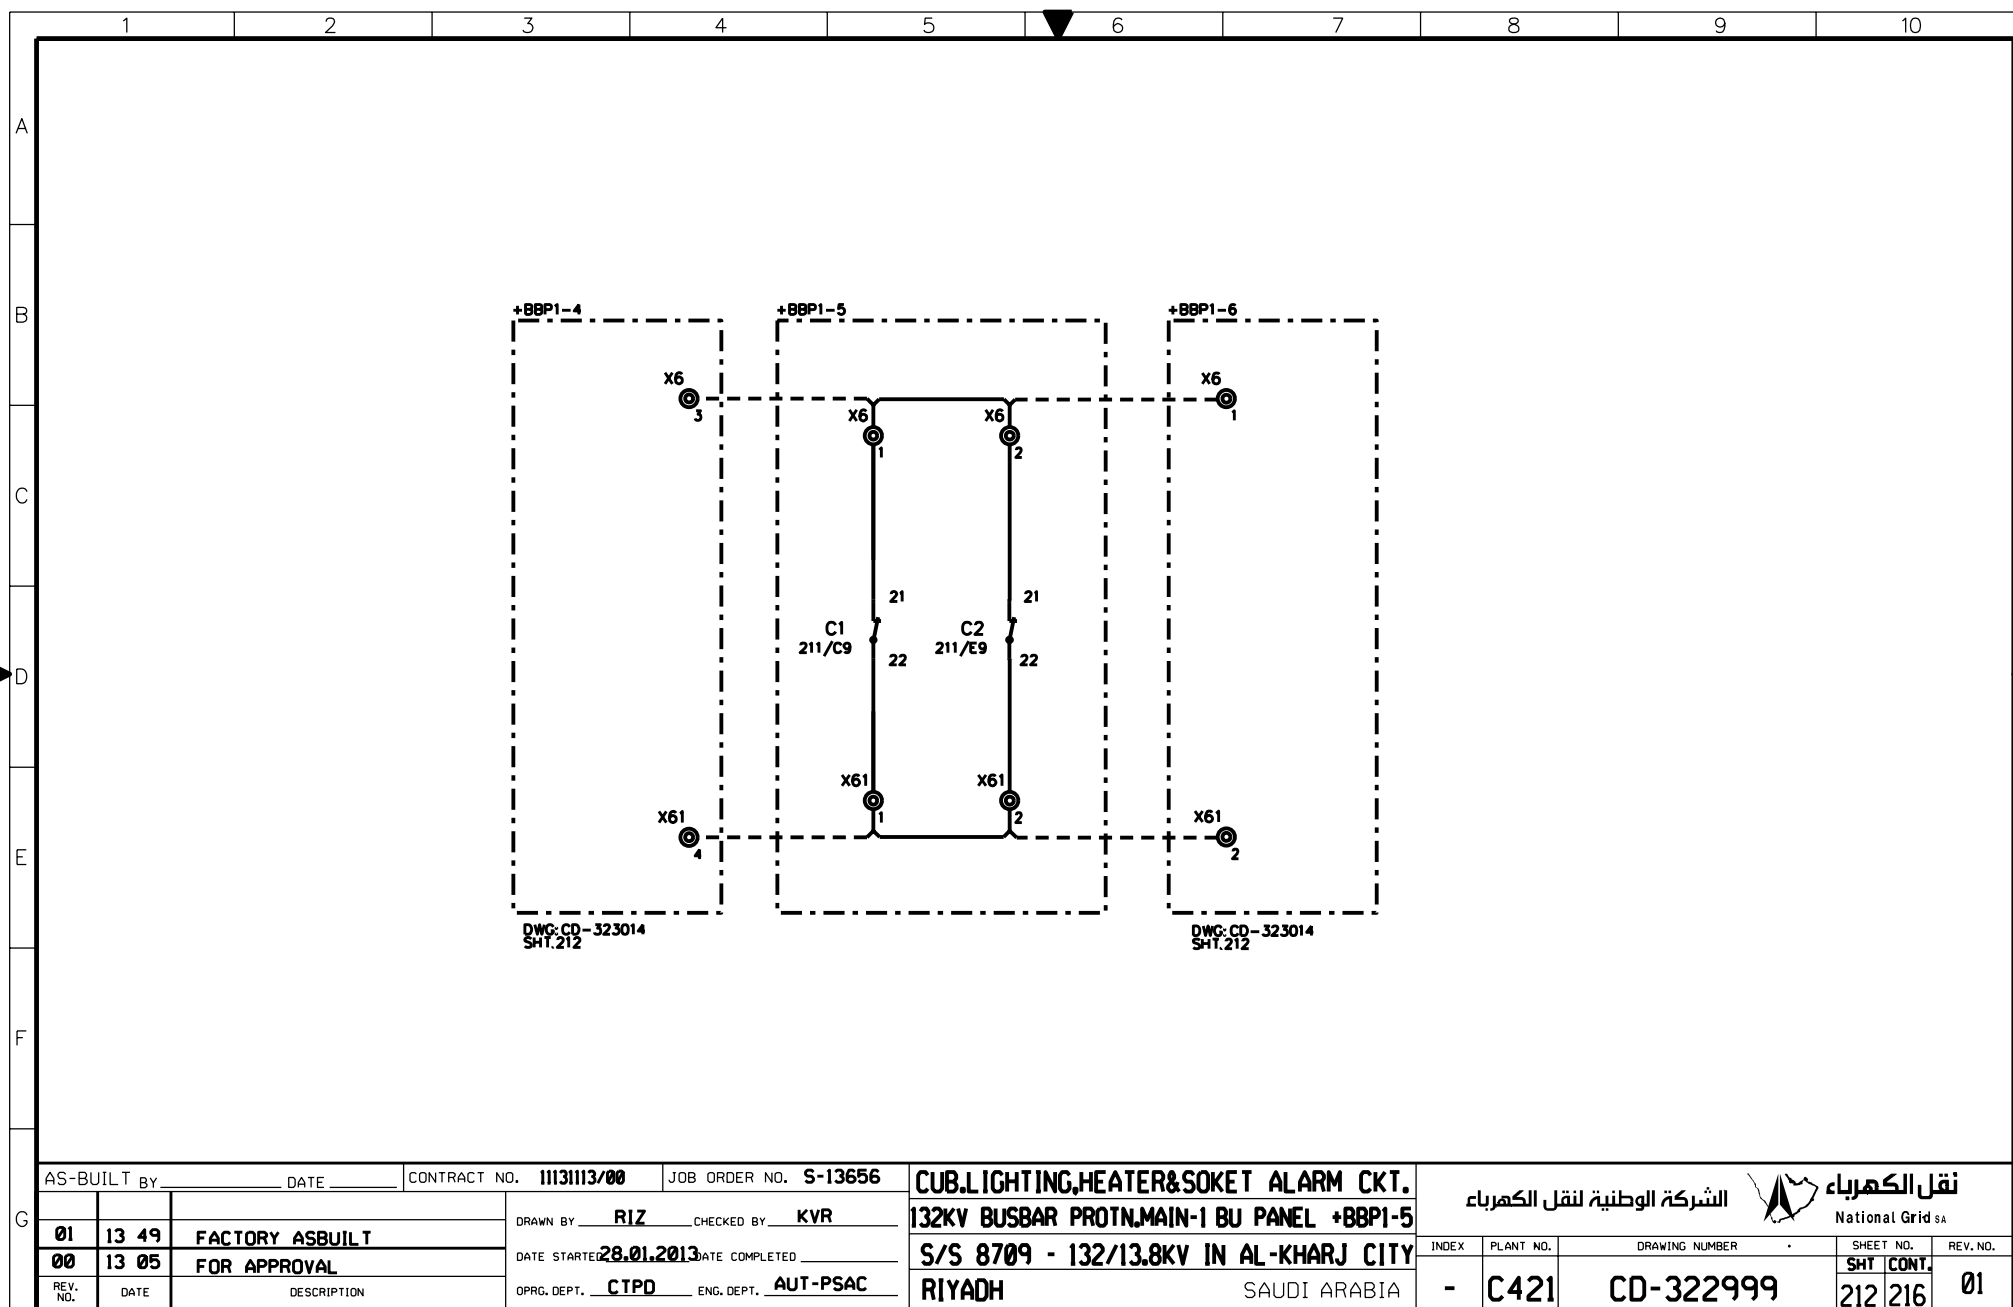

THIS DRAWING AND THE INFORMATION CONTAINED HEREIN ARE THE SOLE PROPERTY OF NATIONAL GRID SA. NO REPRODUCTION IN FULL OR IN PART SHALL BE OBTAINED FROM THIS DOCUMENT WITHOUT THE WRITTEN CONSENT OF ITS OWNER.

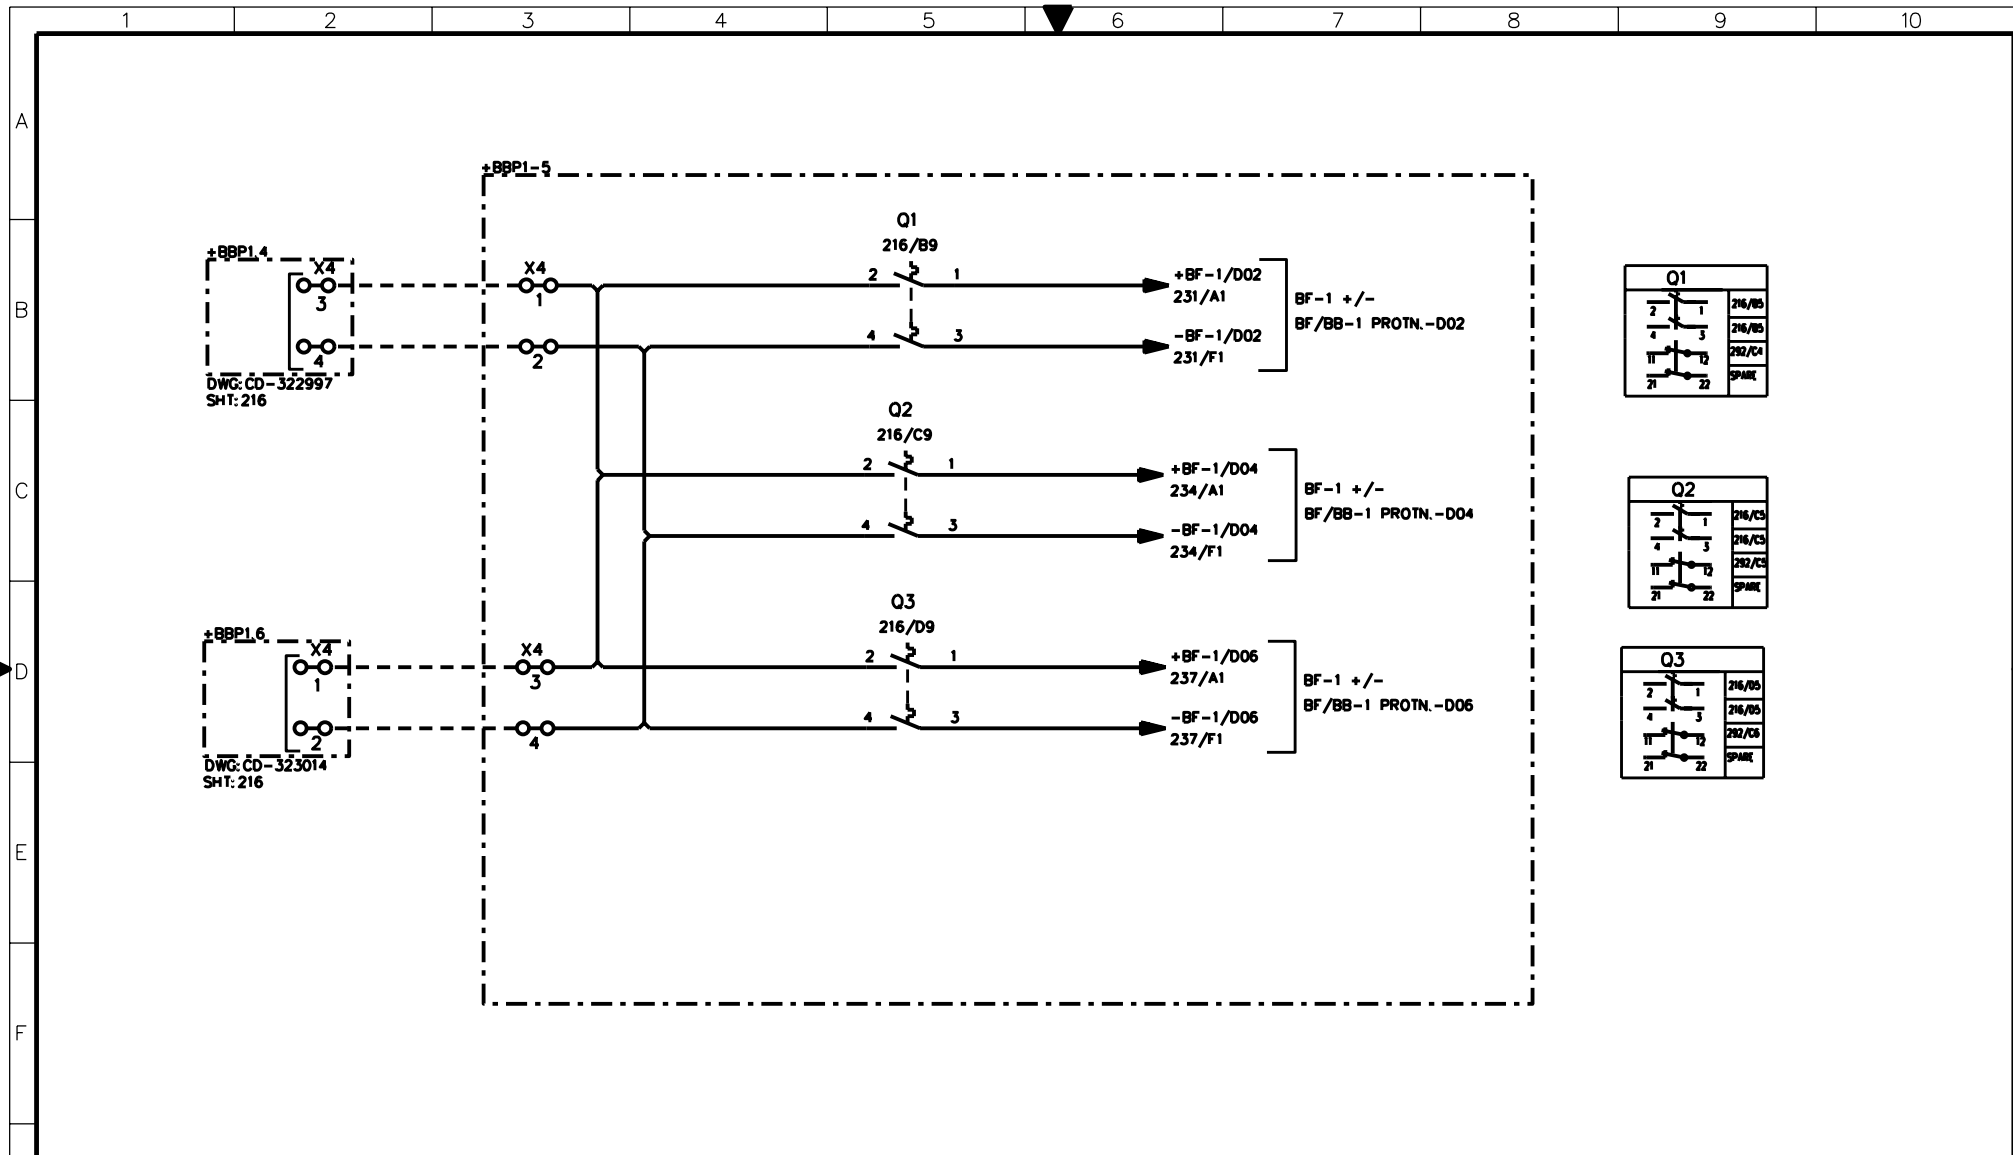

|                                 |  |  |  |  |  |  |                        |  |  |  |  |  |  |  |
|---------------------------------|--|--|--|--|--|--|------------------------|--|--|--|--|--|--|--|
| AS-BUILT BY _____ DATE _____    |  |  | CONTRACT NO. 11131113/00               |  | JOB ORDER NO. S-13656                      |  | DC SUPPLY DISTRIBUTION |  |  |  | نقل الكهرباء<br>الشركة الوطنية لنقل الكهرباء<br>National Grid SA |  |  |  |
|                                 |  |  | DRAWN BY RIZ CHECKED BY KVR            |  | 132KV BUSBAR PROTN.MAIN-1 BU PANEL +BBP1-5 |  |                        |  | INDEX PLANT NO. DRAWING NUMBER SHEET NO. REV. NO.<br>- C421 CD-322999 216 221 01 |  |  |  |  |  |
| 01 13 49<br>00 13 05            |  |  | DATE STARTED 28.01.2013 DATE COMPLETED |  | S/S 8709 - 132/13.8KV IN AL-KHARJ CITY     |  |                        |  |  |  |  |  |  |  |
| FACTORY ASBUILT<br>FOR APPROVAL |  |  | OPRG. DEPT. CTPD ENG. DEPT. AUT-PSAC   |  | RIYADH SAUDI ARABIA                        |  |                        |  |  |  |  |  |  |  |
| REV. NO. DATE DESCRIPTION       |  |  |  |  |  |  |                        |  |  |  |  |  |  |  |

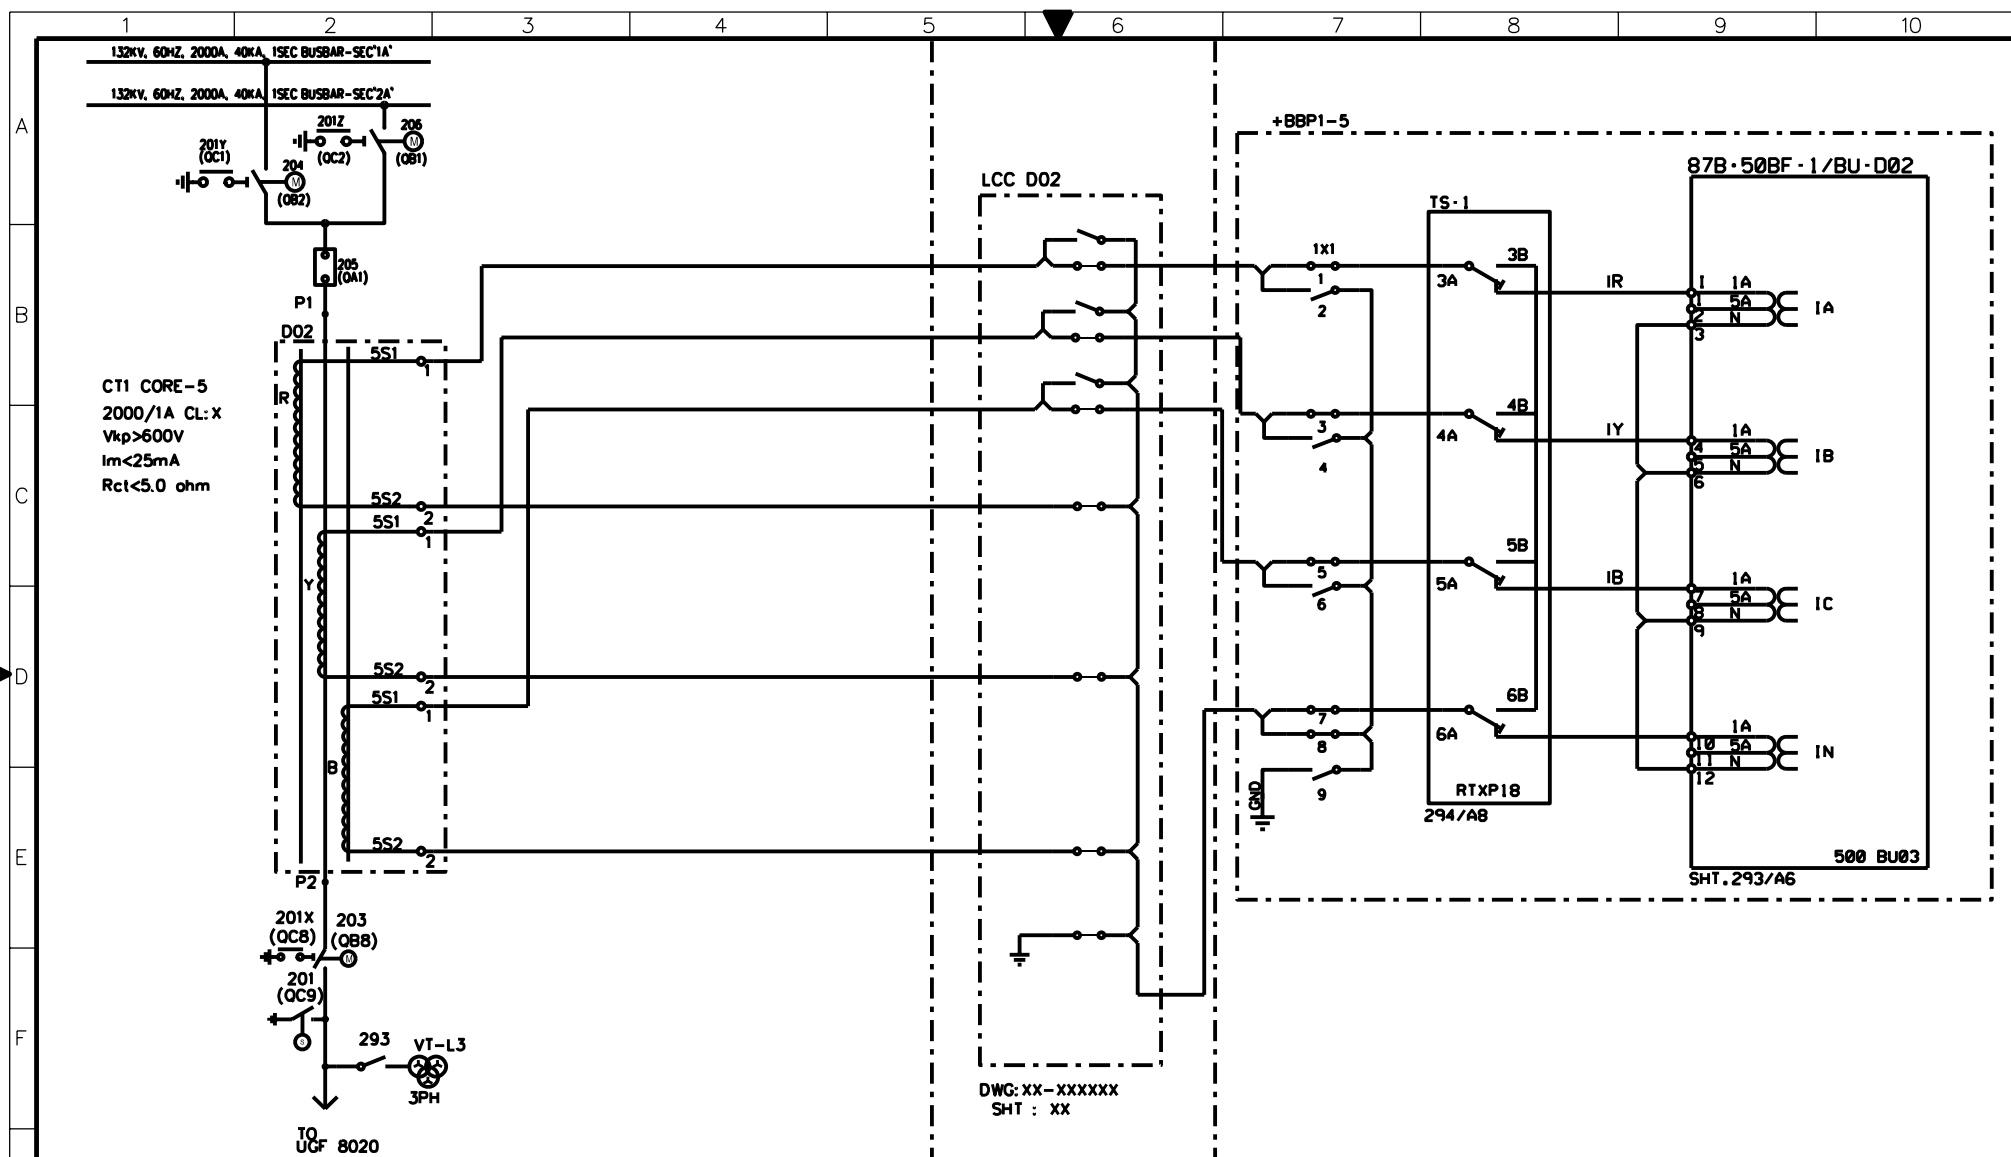

AS-BUILT BY \_\_\_\_\_ DATE \_\_\_\_\_ CONTRACT NO. **11131113/00** JOB ORDER NO. **S-13656**

| 01       | 13 49 | FACTORY ASBUILT |
|----------|-------|-----------------|
| 00       | 13 05 | FOR APPROVAL    |
| REV. NO. | DATE  | DESCRIPTION     |

DRAWN BY **RIZ** CHECKED BY **KVR**

DATE STARTED **28.01.2013** DATE COMPLETED \_\_\_\_\_

OPRG. DEPT. **CTPD** ENG. DEPT. **AUT-PSAC**

**CURRENT TRANSFORMER INPUTS -87B+50BF-1/BU-D02**

**132KV BUSBAR PROT.N.MAIN-1 BU PANEL +BBP1-5**


**S/S 8709 - 132/13.8KV IN AL-KHARJ CITY**

**R/YADH SAUDI ARABIA**

| الشركة الوطنية لنقل الكهرباء |           | National Grid sa |           |
|------------------------------|-----------|------------------|-----------|
| INDEX                        | PLANT NO. | DRAWING NUMBER   | SHEET NO. |
| -                            | C421      | CD-322999        | 221 222   |
|                              |           |                  | 01        |





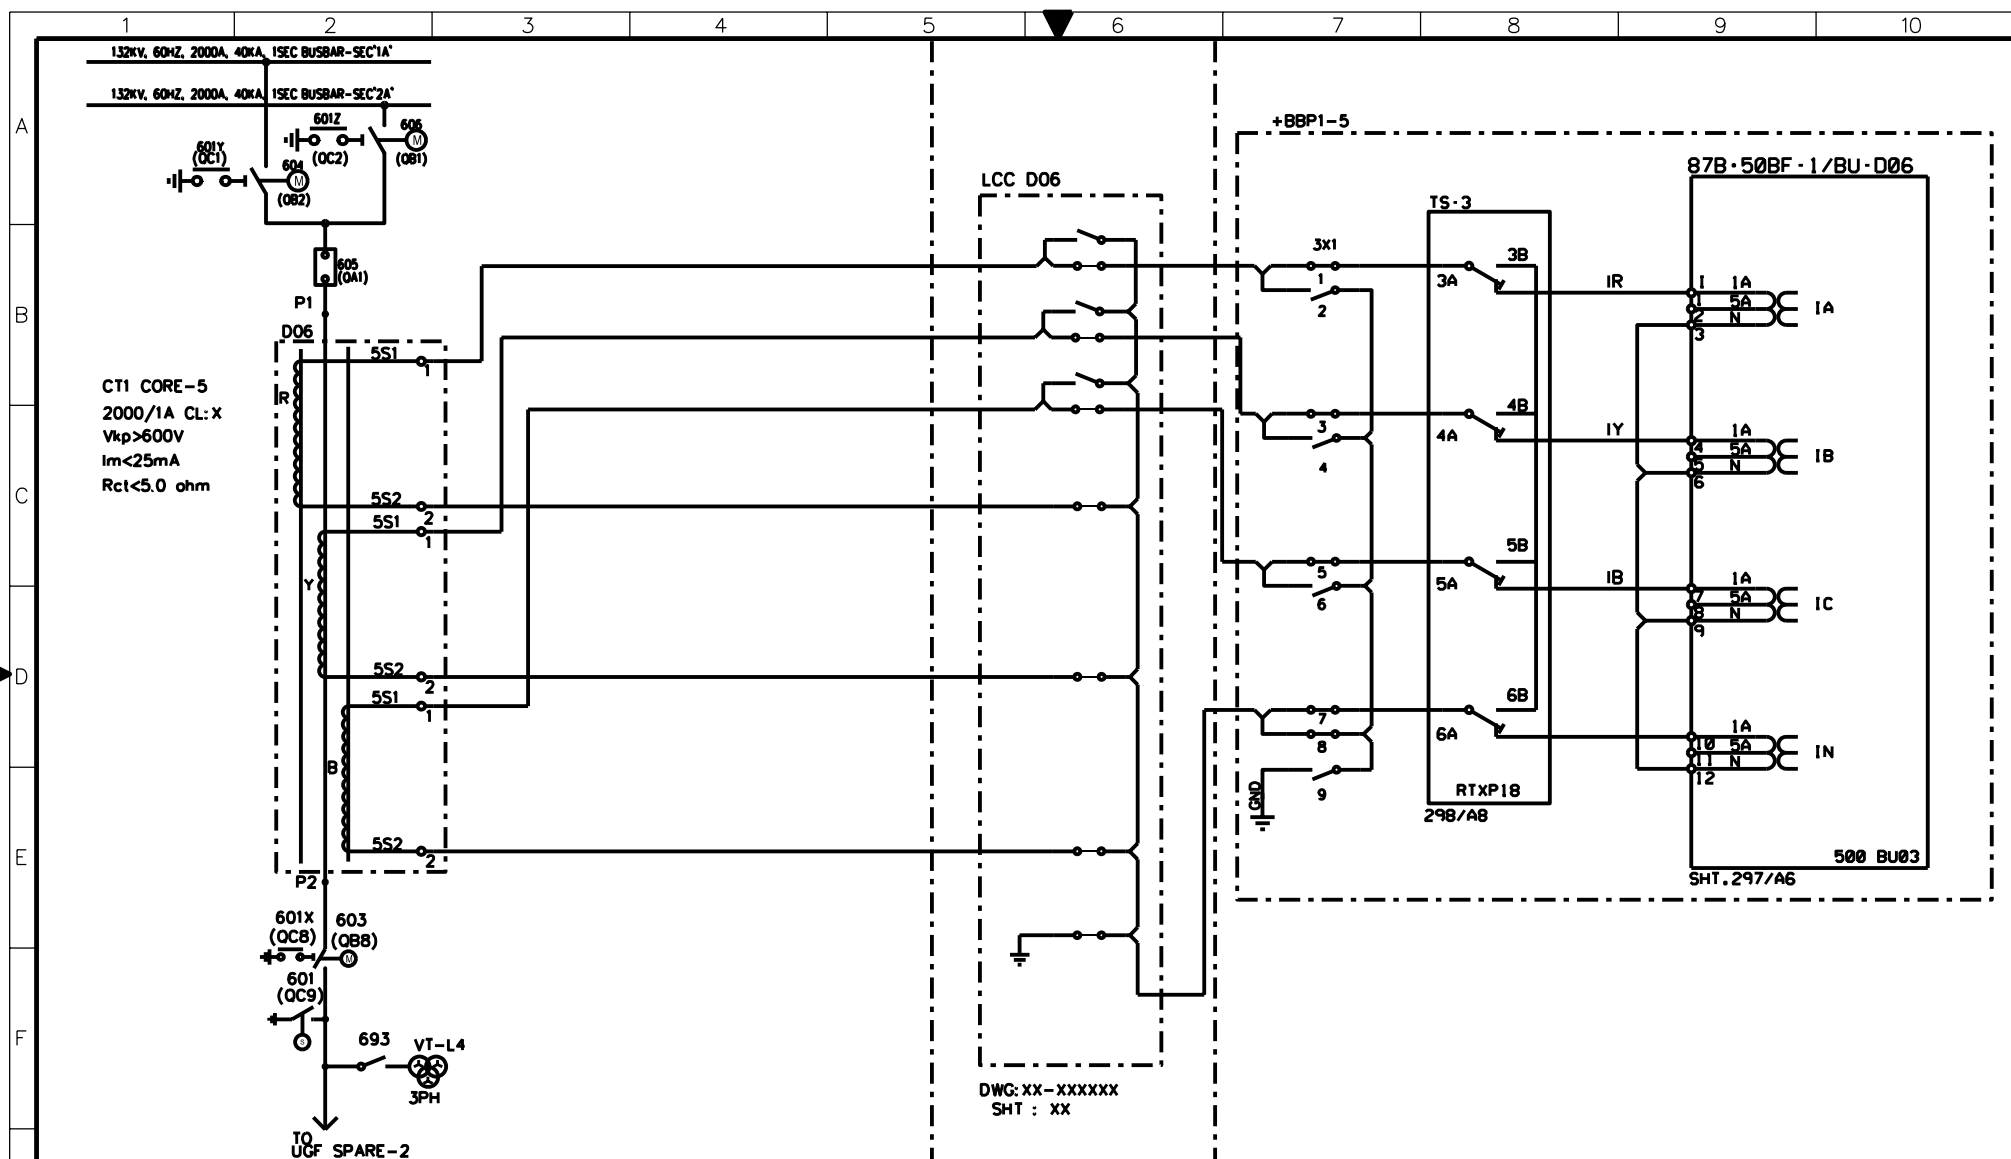


AS-BUILT BY \_\_\_\_\_ DATE \_\_\_\_\_ CONTRACT NO. **11131113/00** JOB ORDER NO. **S-13656**

| 01       | 13 49 | FACTORY ASBUILT |
|----------|-------|-----------------|
| 00       | 13 05 | FOR APPROVAL    |
| REV. NO. | DATE  | DESCRIPTION     |


DRAWN BY **RIZ** CHECKED BY **KVR**  
 DATE STARTED **28.01.2013** DATE COMPLETED \_\_\_\_\_  
 OPRG. DEPT. **CTPD** ENG. DEPT. **AUT-PSAC**

**CURRENT TRANSFORMER INPUTS -87B+50BF-1/BU-D06**  
**132KV BUSBAR PROTN.MAIN-1 BU PANEL +BBP1-5**  
**S/S 8709 - 132/13.8KV IN AL-KHARJ CITY**  
**RIYADH SAUDI ARABIA**


| الشركة الوطنية لنقل الكهرباء |           | National Grid sa |           |
|------------------------------|-----------|------------------|-----------|
| INDEX                        | PLANT NO. | DRAWING NUMBER   | SHEET NO. |
| -                            | C421      | CD-322999        | 223/231   |
|                              |           |                  | 01        |

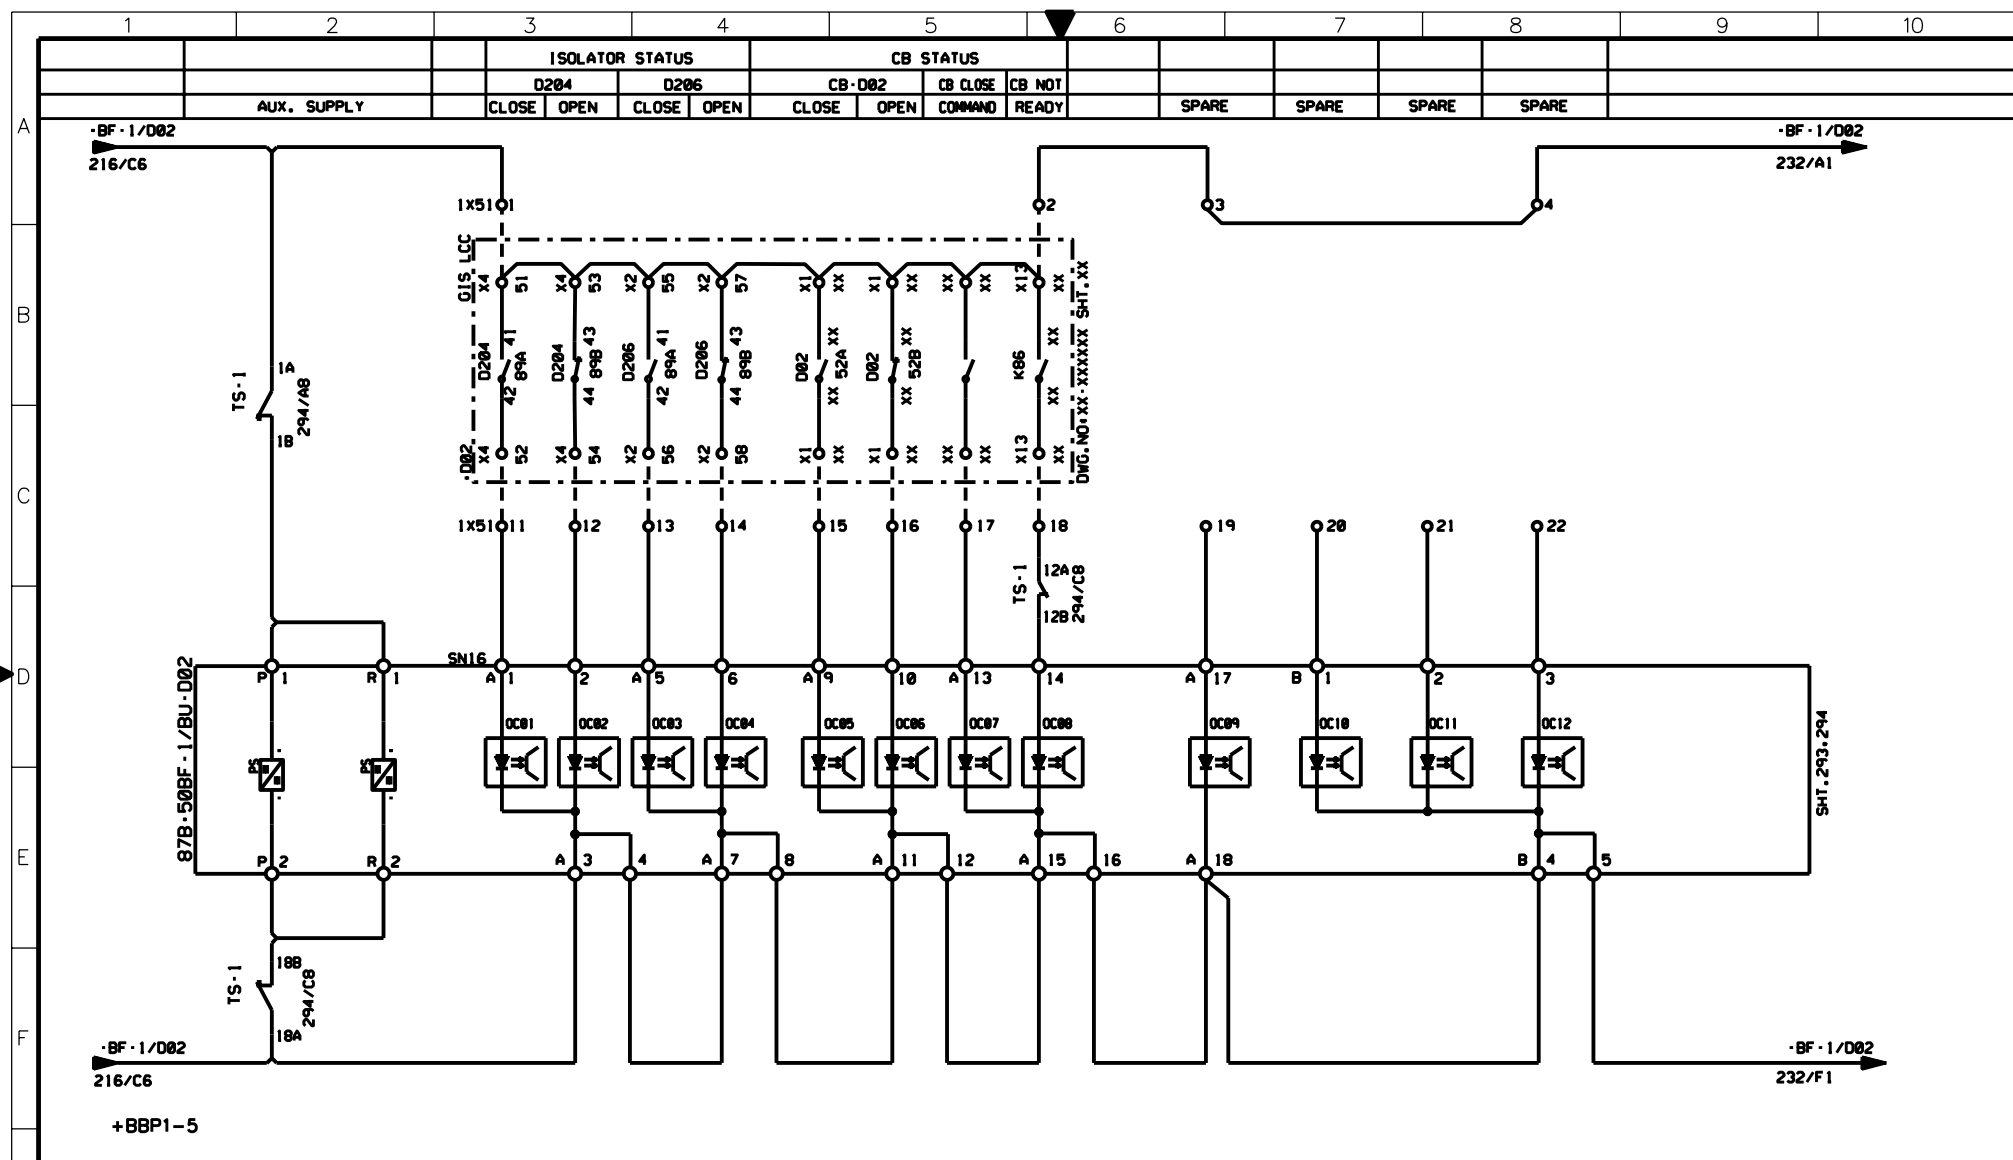


|                              |       |                          |  |  |  |  |  |   |  |
|------------------------------|-------|--------------------------|--|--|--|--|--|---|--|
| AS-BUILT BY _____ DATE _____ |       | CONTRACT NO. 11131113/00 |  | JOB ORDER NO. S-13656                        |  | 87B-50BF-1/BU-D02 PROTECTION RELAY - BINARY INPUTS |  | الشركة الوطنية لنقل الكهرباء                      |  |
| 01                           | 13 49 | FACTORY ASBUILT          |  | DRAWN BY RIZ CHECKED BY KVR                  |  | 132KV BUSBAR PROTN, MAIN-1 BU PANEL +BBP1-5        |  | National Grid sa                                  |  |
| 00                           | 13 05 | FOR APPROVAL             |  | DATE STARTED 28.01.2013 DATE COMPLETED _____ |  | S/S 8709 - 132/13.8KV IN AL-KHARJ CITY             |  | INDEX PLANT NO. DRAWING NUMBER SHEET NO. REV. NO. |  |
| REV. NO.                     | DATE  | DESCRIPTION              |  | OPRG. DEPT. CTPD ENG. DEPT. AUT-PSAC         |  | RIYADH SAUDI ARABIA                                |  | - C421 CD-322999 231 232 01                       |  |

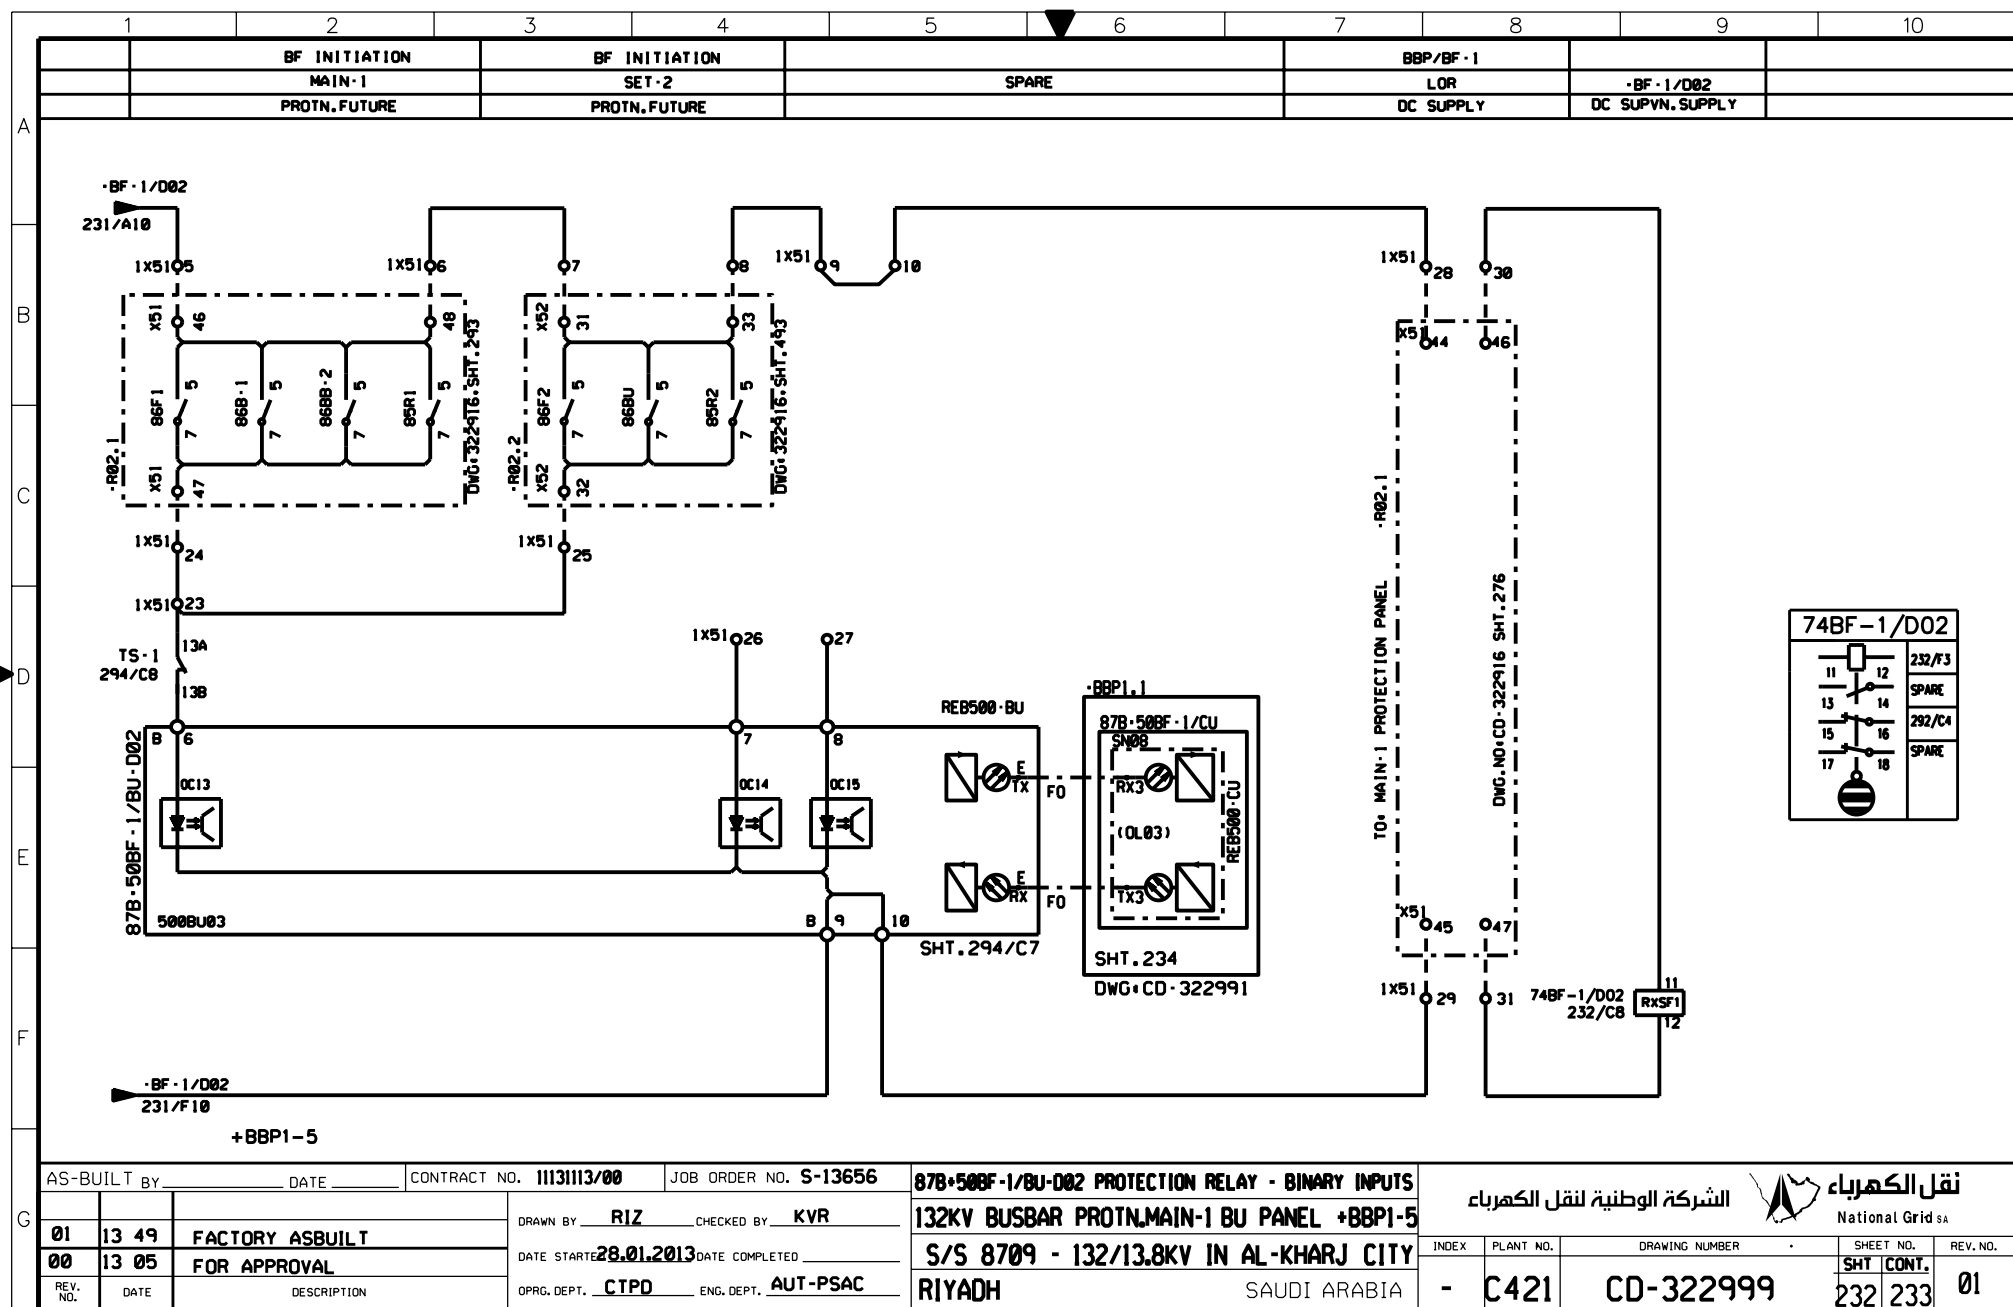

THIS DRAWING AND THE INFORMATION CONTAINED HEREIN ARE THE SOLE PROPERTY OF NATIONAL GRID SA. NO REPRODUCTION IN FULL OR IN PART SHALL BE OBTAINED FROM THIS DOCUMENT WITHOUT THE WRITTEN CONSENT OF ITS OWNER.

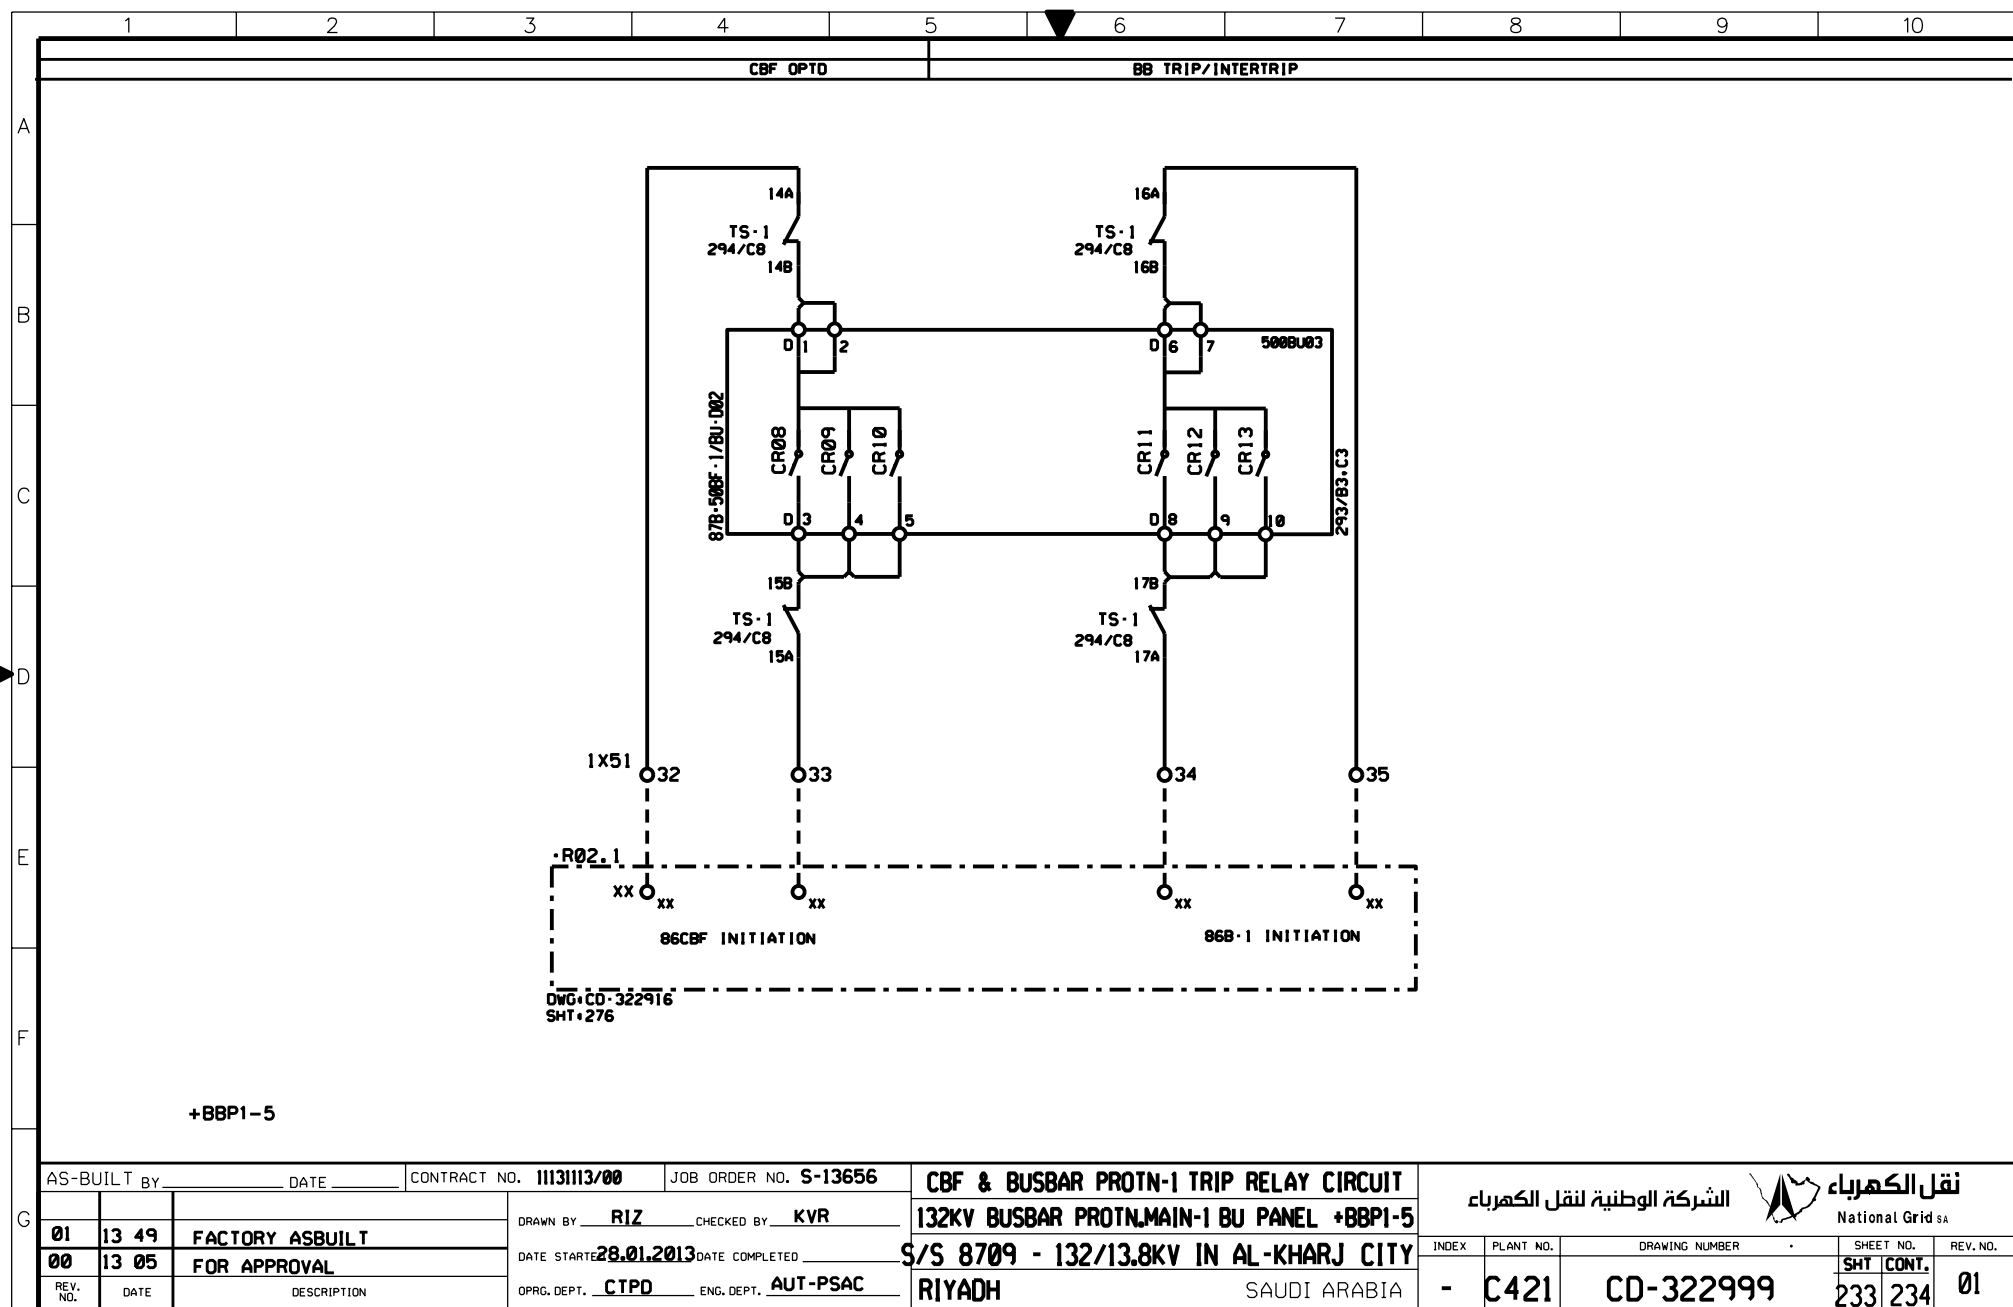




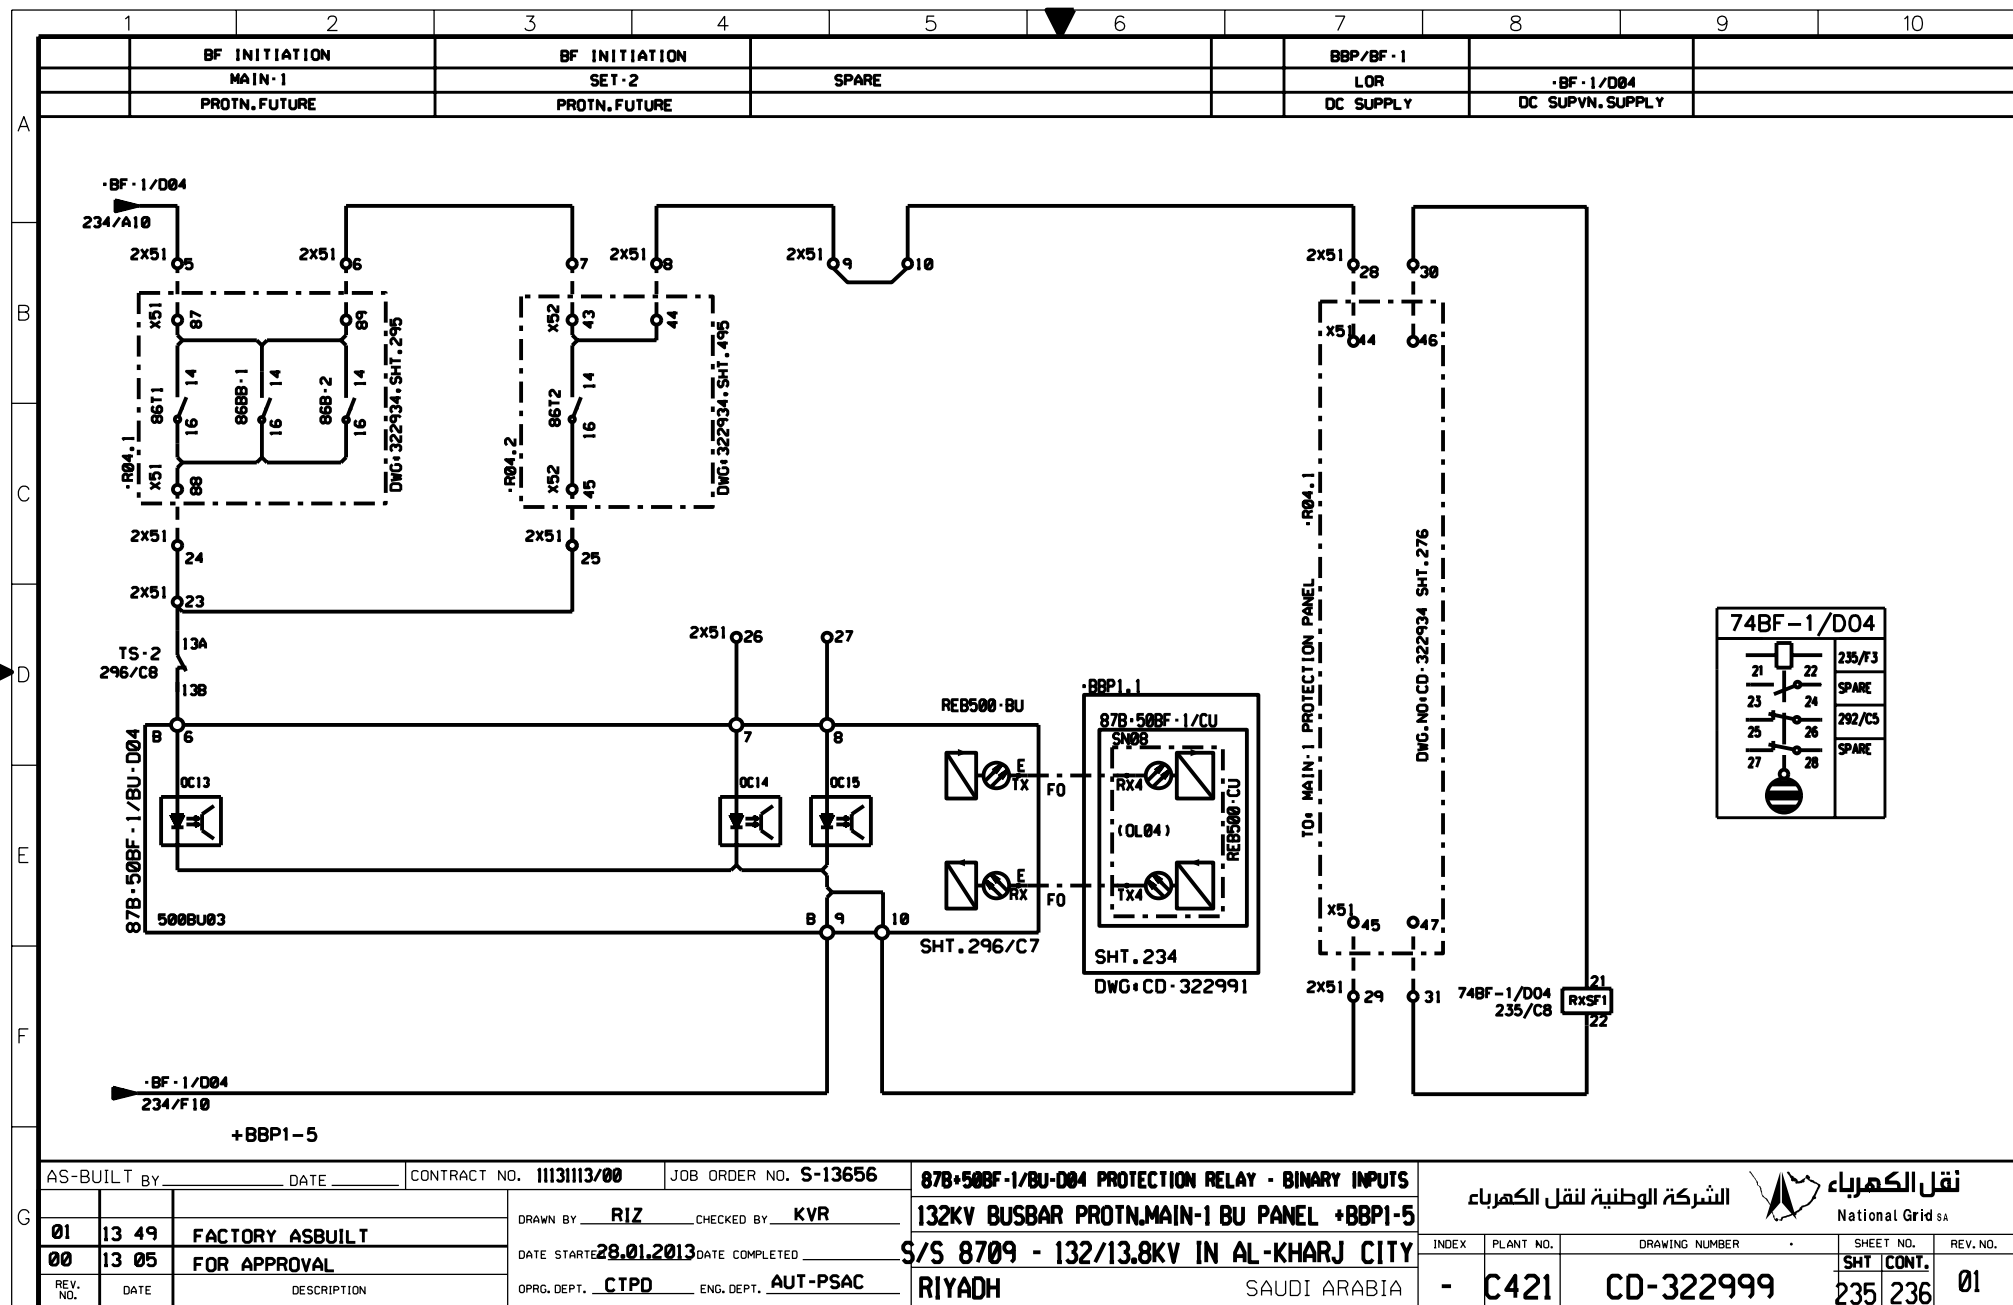

THIS DRAWING AND THE INFORMATION CONTAINED HEREIN ARE THE SOLE PROPERTY OF NGD200. NO REPRODUCTION IN FULL OR IN PART SHALL BE OBTAINED FROM THIS DOCUMENT WITHOUT THE WRITTEN CONSENT OF ITS OWNER.




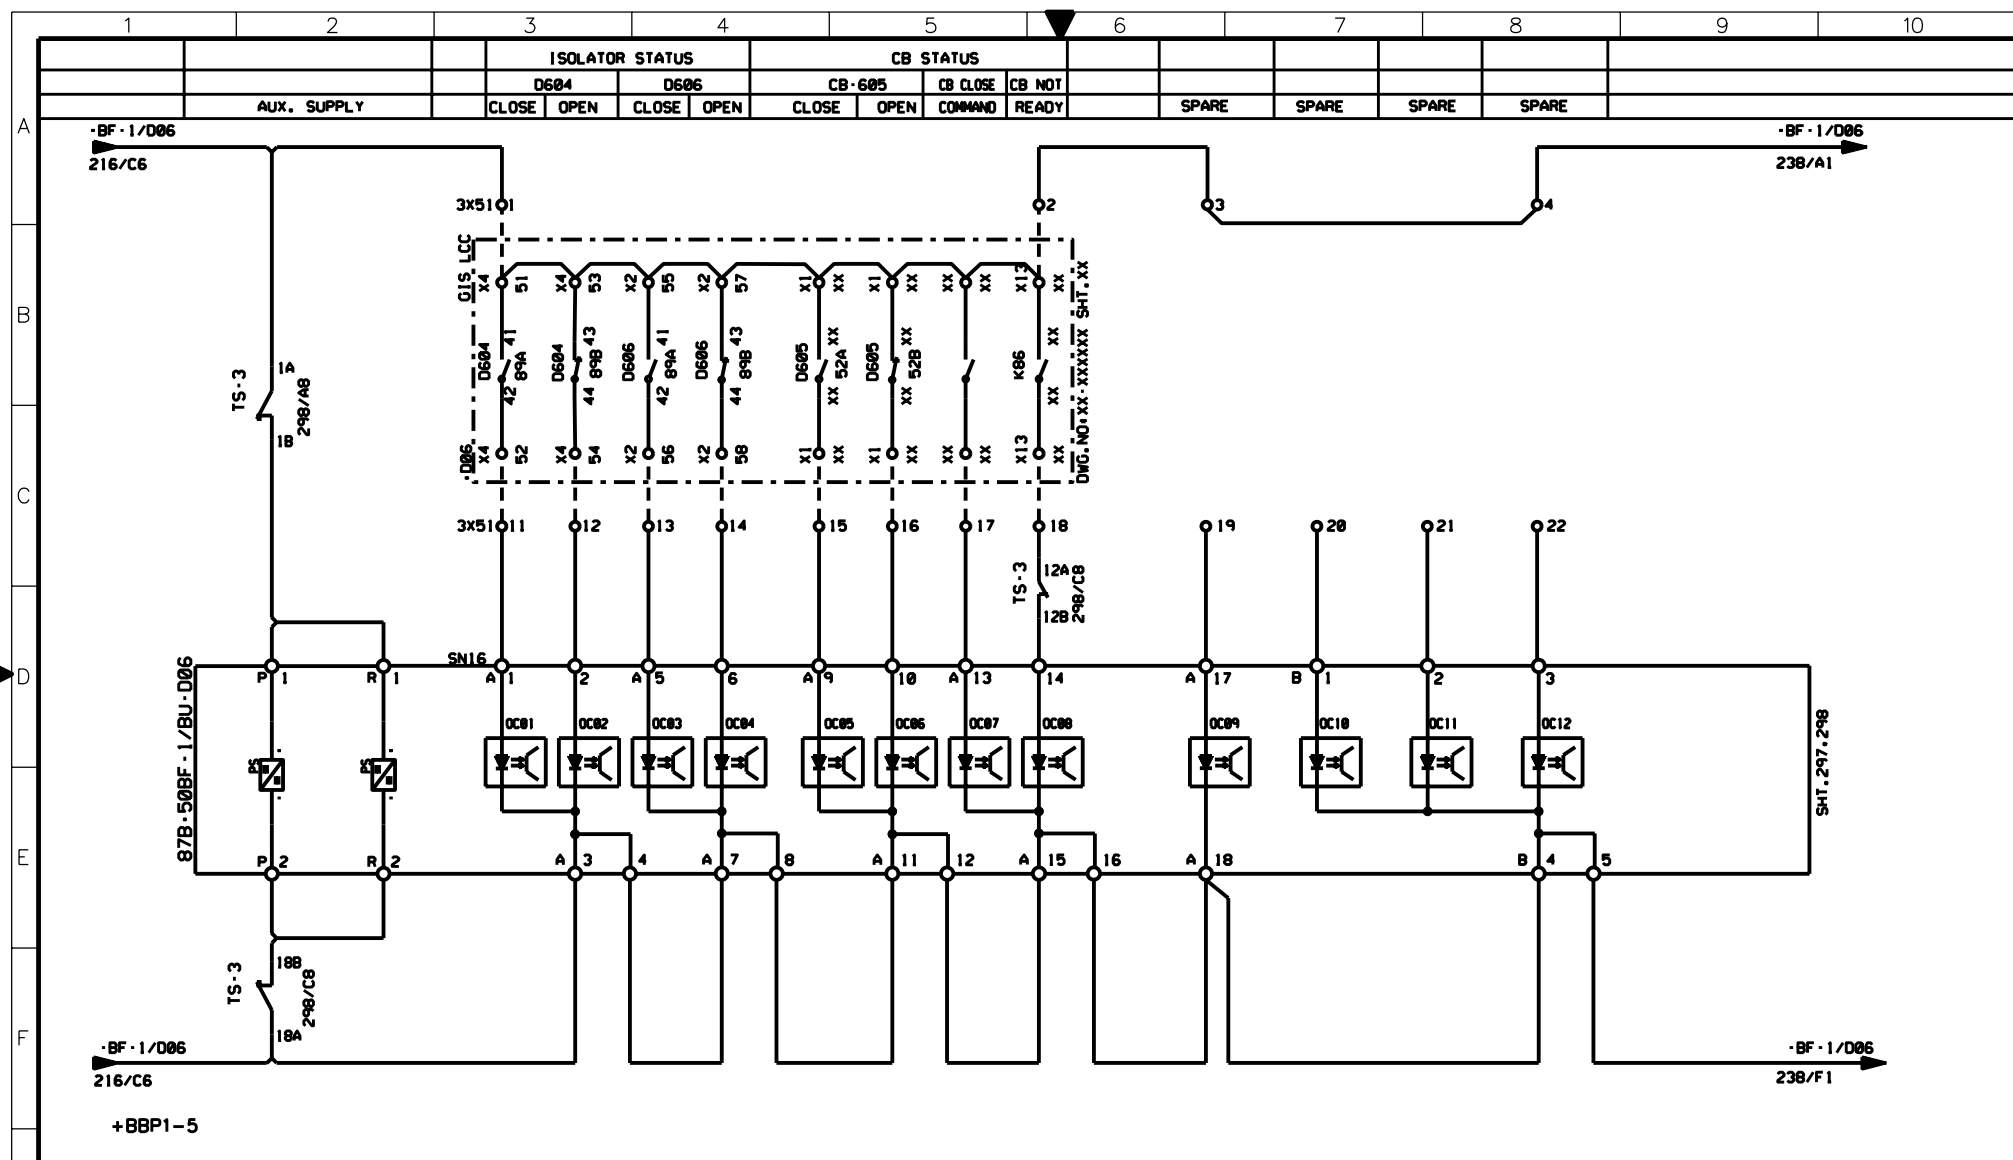



|                              |       |  |                       |  |  |                              |           |                |           |
|------------------------------|-------|--|-----------------------|--|--|------------------------------|-----------|----------------|-----------|
| AS-BUILT BY _____ DATE _____ |       | CONTRACT NO. 11131113/00                     | JOB ORDER NO. S-13656 | 87B-50BF-1/BU-D06 PROTECTION RELAY - BINARY INPUTS |  | الشركة الوطنية لنقل الكهرباء |           | نقل الكهرباء   |           |
| DRAWN BY RIZ CHECKED BY KVR  |       | DATE STARTED 28.01.2013 DATE COMPLETED _____ |                       | 132KV BUSBAR PROTN. MAIN-1 BU PANEL +BBP1-5        |  | National Grid sa             |           |                |           |
| FOR APPROVAL                 |       | OPRG. DEPT. CTPD ENG. DEPT. AUT-PSAC         |                       | S/S 8709 - 132/13.8KV IN AL-KHARJ CITY             |  | INDEX                        | PLANT NO. | DRAWING NUMBER | SHEET NO. |
| REV. NO.                     | DATE  | DESCRIPTION                                  |                       | RIYADH SAUDI ARABIA                                |  | -                            | C421      | CD-322999      | 237       |
| 01                           | 13 49 | FACTORY ASBUILT                              |                       |  |  |                              |           |                | CONT.     |
| 00                           | 13 05 |  |                       |  |  |                              |           |                | 01        |






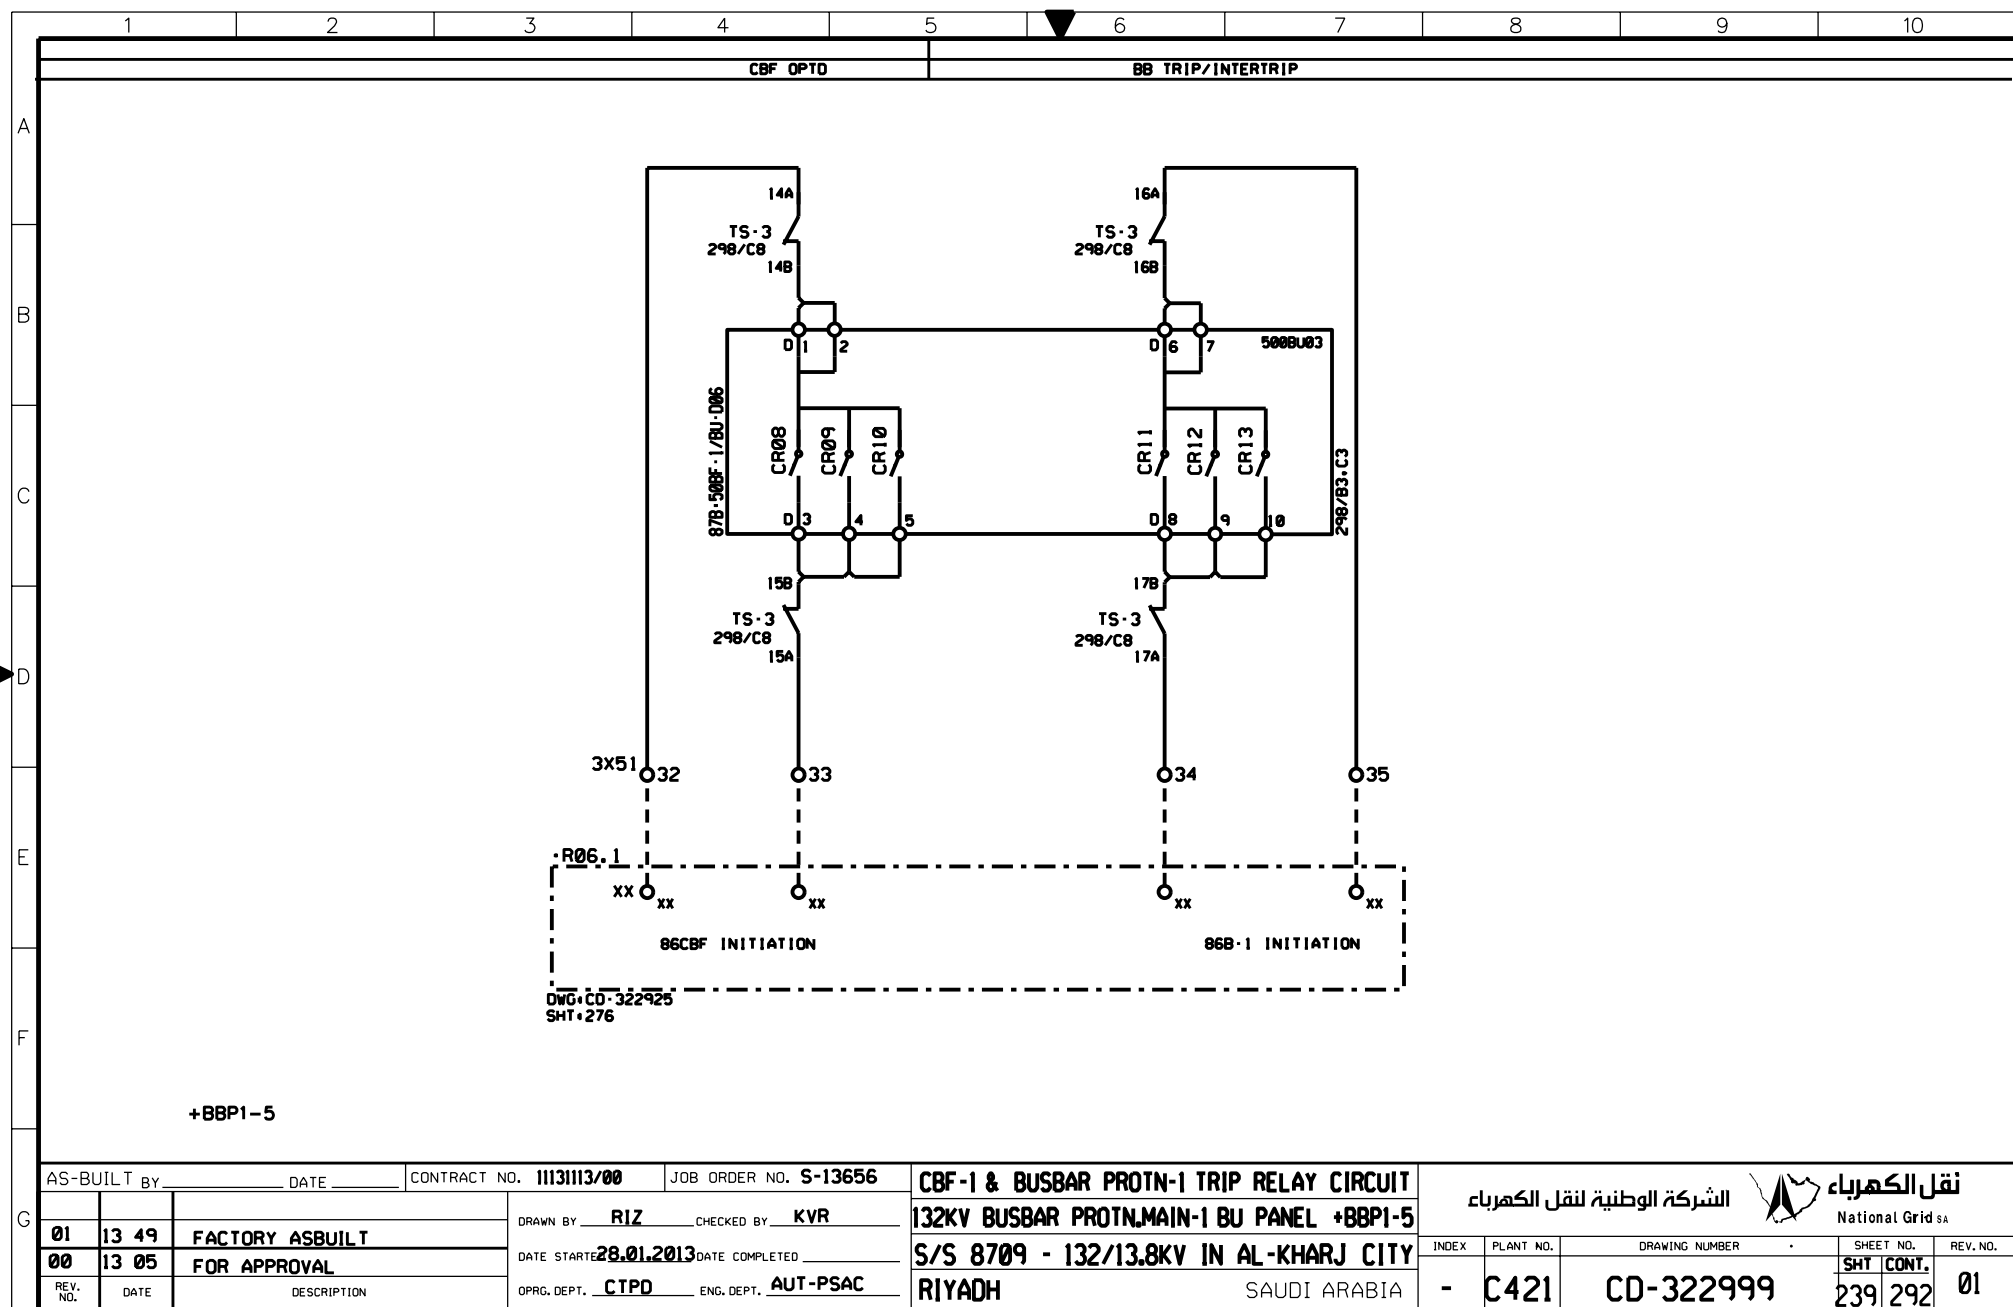

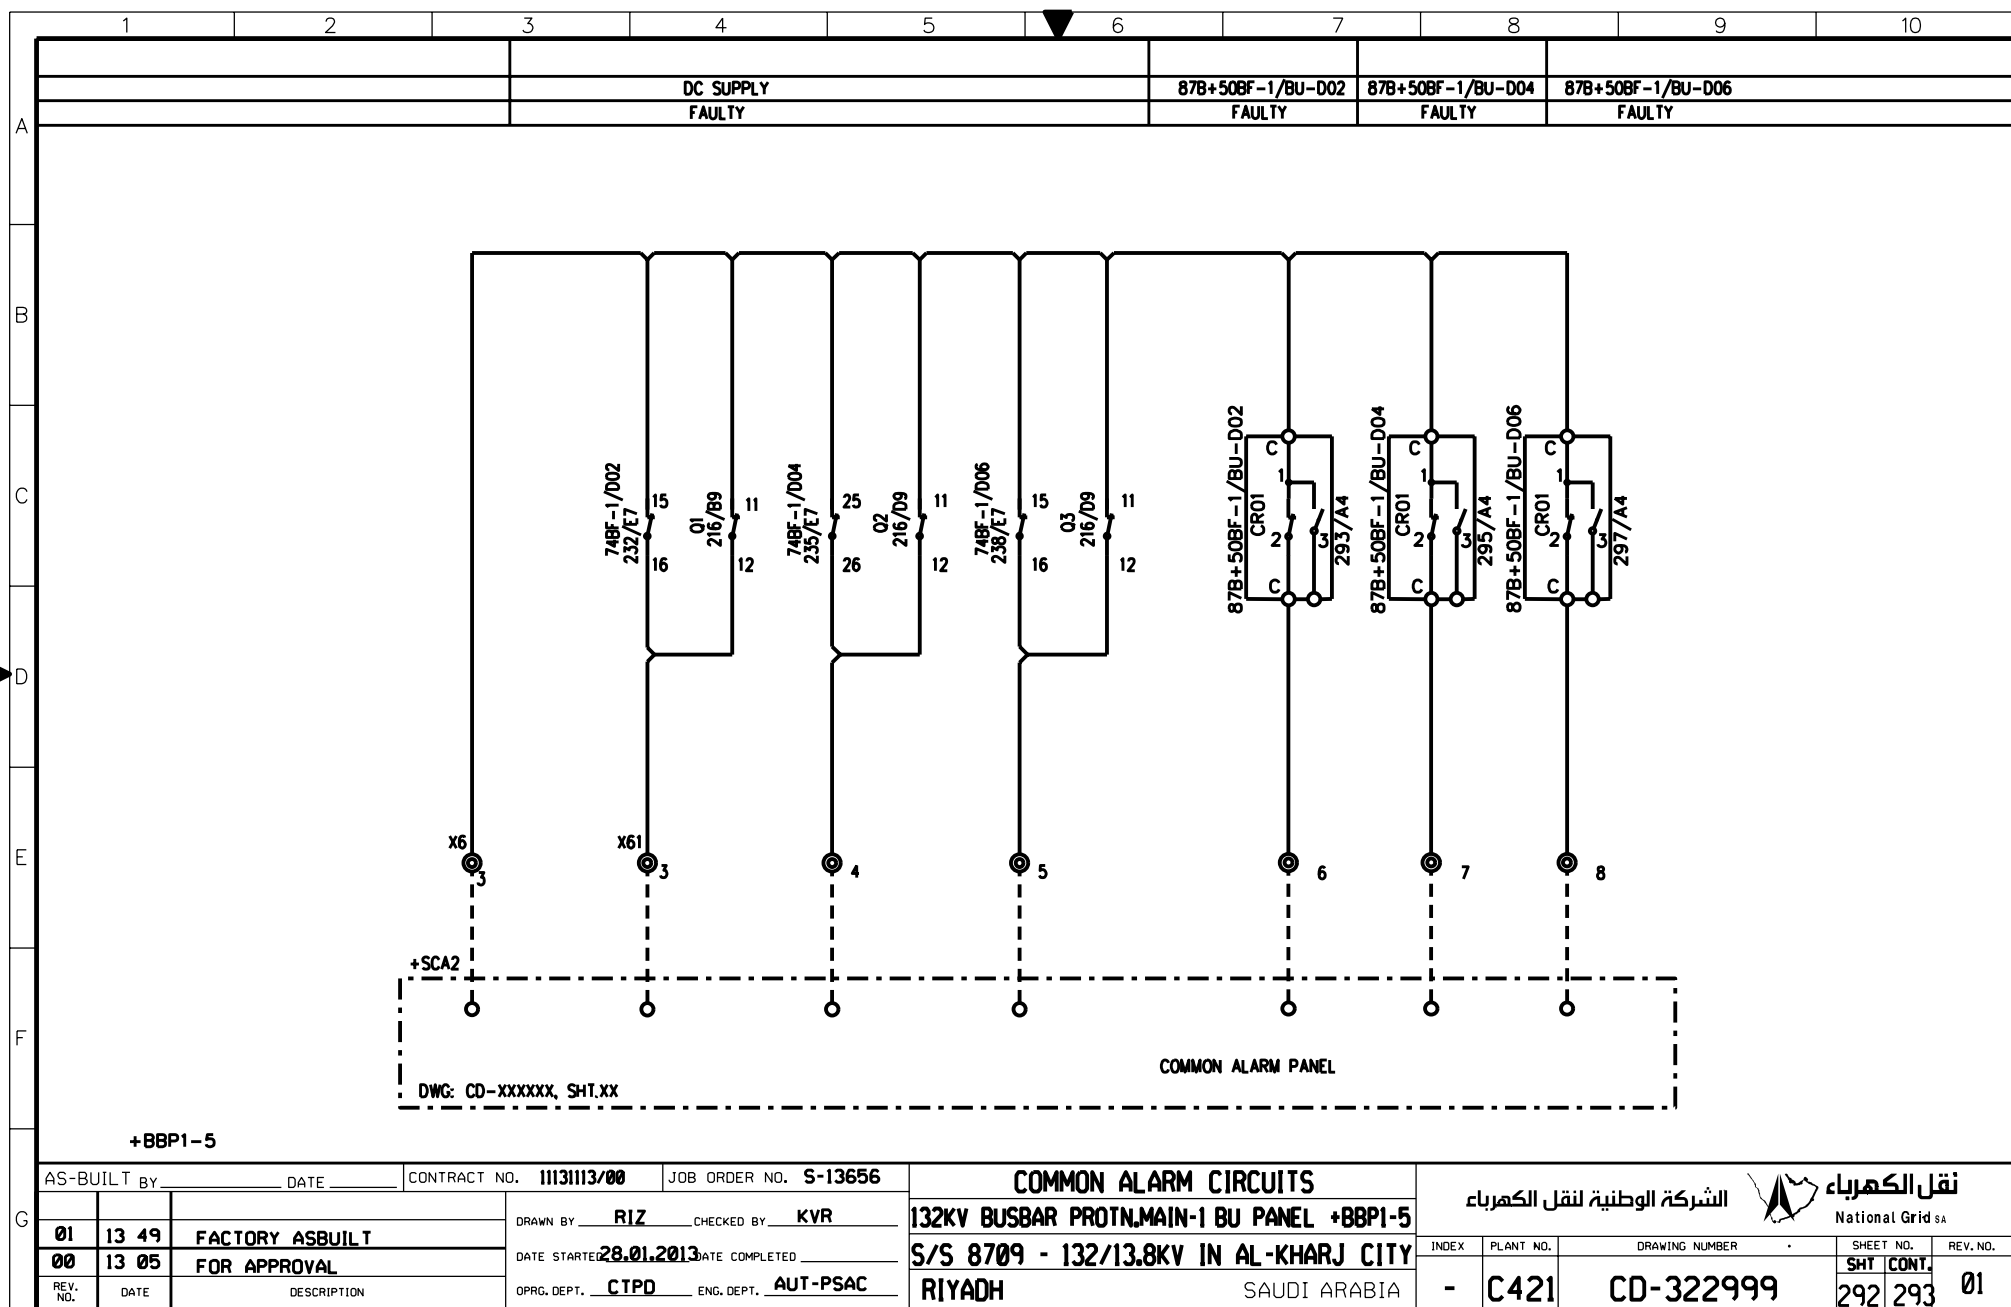

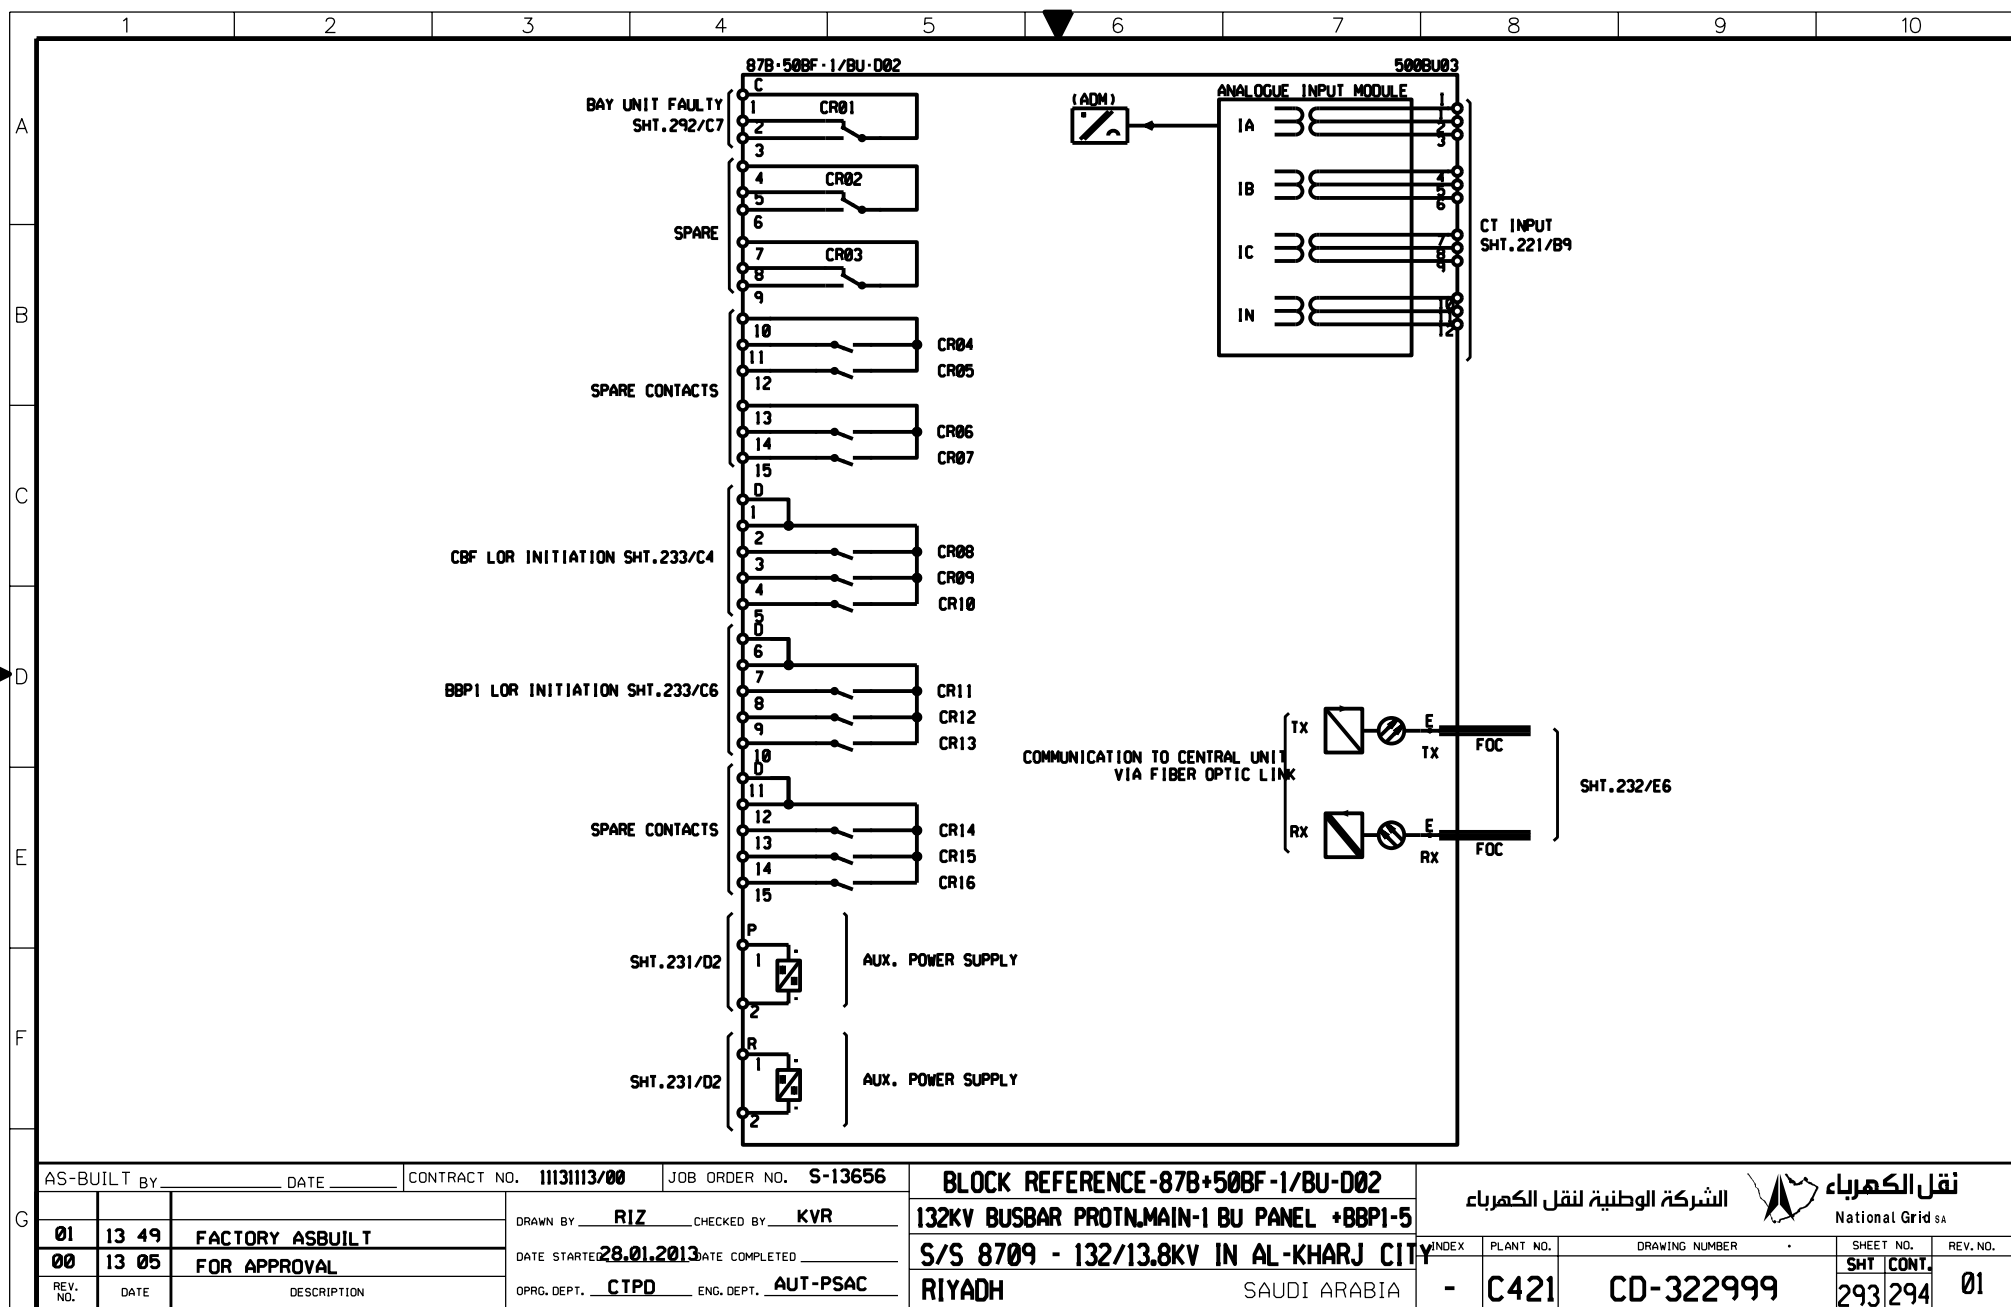


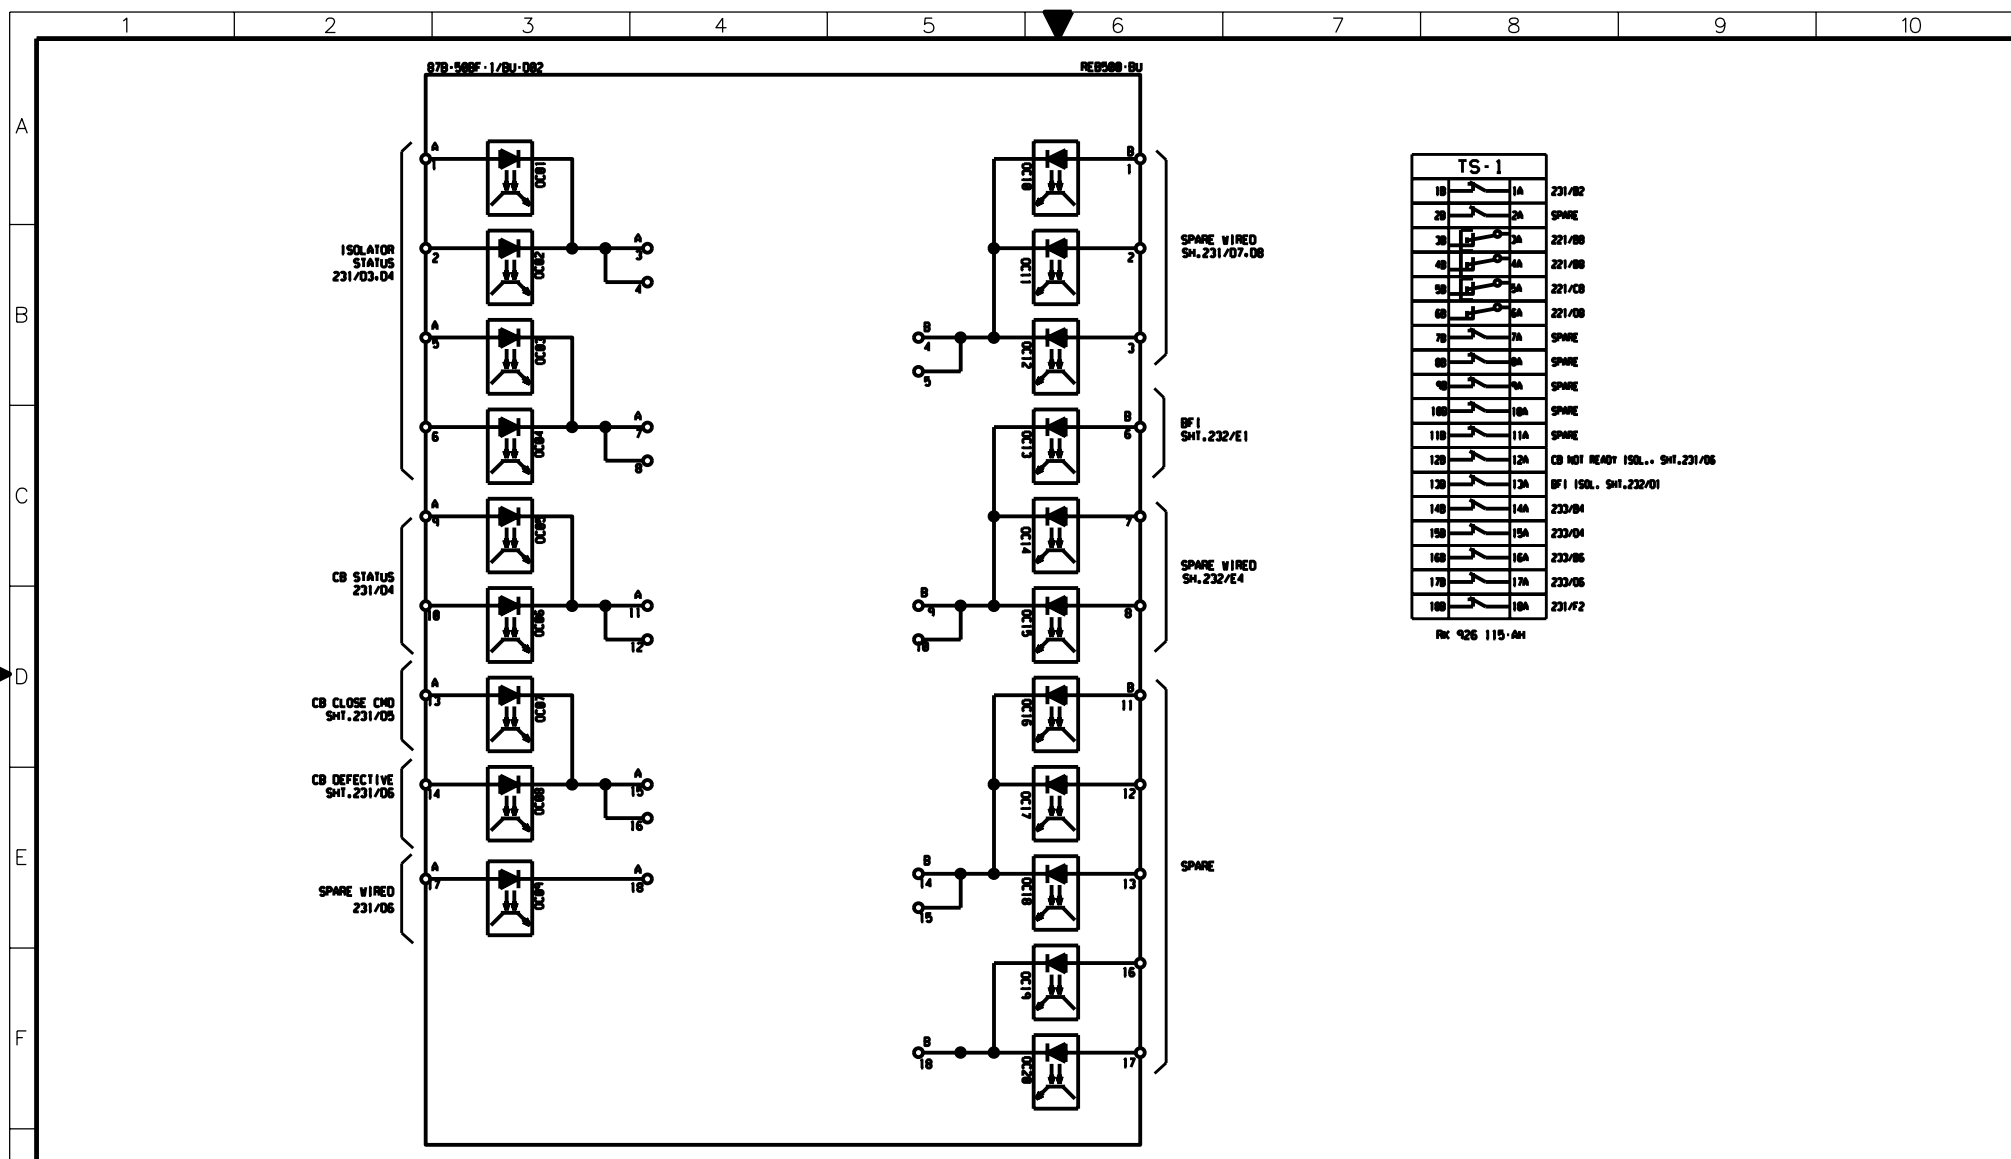


| TS-1 |     |                                 |
|------|-----|---------------------------------|
| 1B   | 1A  | 231/02                          |
| 2B   | 2A  | SPARE                           |
| 3B   | 3A  | 221/08                          |
| 4B   | 4A  | 221/08                          |
| 5B   | 5A  | 221/08                          |
| 6B   | 6A  | 221/08                          |
| 7B   | 7A  | SPARE                           |
| 8B   | 8A  | SPARE                           |
| 9B   | 9A  | SPARE                           |
| 10B  | 10A | SPARE                           |
| 11B  | 11A | SPARE                           |
| 12B  | 12A | CB NOT READY ISOL... SH1.231/06 |
| 13B  | 13A | BF I ISOL... SH1.232/01         |
| 14B  | 14A | 233/04                          |
| 15B  | 15A | 233/04                          |
| 16B  | 16A | 233/06                          |
| 17B  | 17A | 233/06                          |
| 18B  | 18A | 231/02                          |

RK 926 115-AM

|   |              |   |                              |   |             |                              |            |              |           |
|---|--------------|---|------------------------------|---|-------------|------------------------------|------------|--------------|-----------|
| AS-BUILT BY _____ DATE _____                      |              | CONTRACT NO. <b>1113113/00</b>                      | JOB ORDER NO. <b>S-13656</b> | <b>BLOCK REFERENCE-87B+50BF-1/BU-D02</b>          |             | الشركة الوطنية لنقل الكهرباء |            | نقل الكهرباء |           |
| DRAWN BY <b>RIZ</b> CHECKED BY <b>KVR</b>         |              | DATE STARTED <b>28.01.2013</b> DATE COMPLETED _____ |                              | <b>132KV BUSBAR PROTN.MAIN-1 BU PANEL +88P1-5</b> |             | National Grid sa             |            |              |           |
| PRG. DEPT. <b>CTPD</b> ENG. DEPT. <b>AUT-PSAC</b> |              | <b>\$/S 8709 - 132/13.8KV IN AL-KHARJ CITY</b>      |                              | <b>RIYADH</b>                                     |             | <b>SAUDI ARABIA</b>          |            |              |           |
| REV. NO.  | DATE         | DESCRIPTION   |                              | INDEX   | PLANT NO.   | DRAWING NUMBER               | SHEET NO.  | REV. NO.     |           |
| <b>01</b>   | <b>13 49</b> | <b>FACTORY ASBUILT</b>                              |                              | -   | <b>C421</b> | <b>CD-322999</b>             | <b>294</b> | <b>295</b>   | <b>01</b> |
| <b>00</b>   | <b>13 05</b> | <b>FOR APPROVAL</b>                                 |                              |   |             |                              | <b>SH1</b> | <b>CONT.</b> |           |

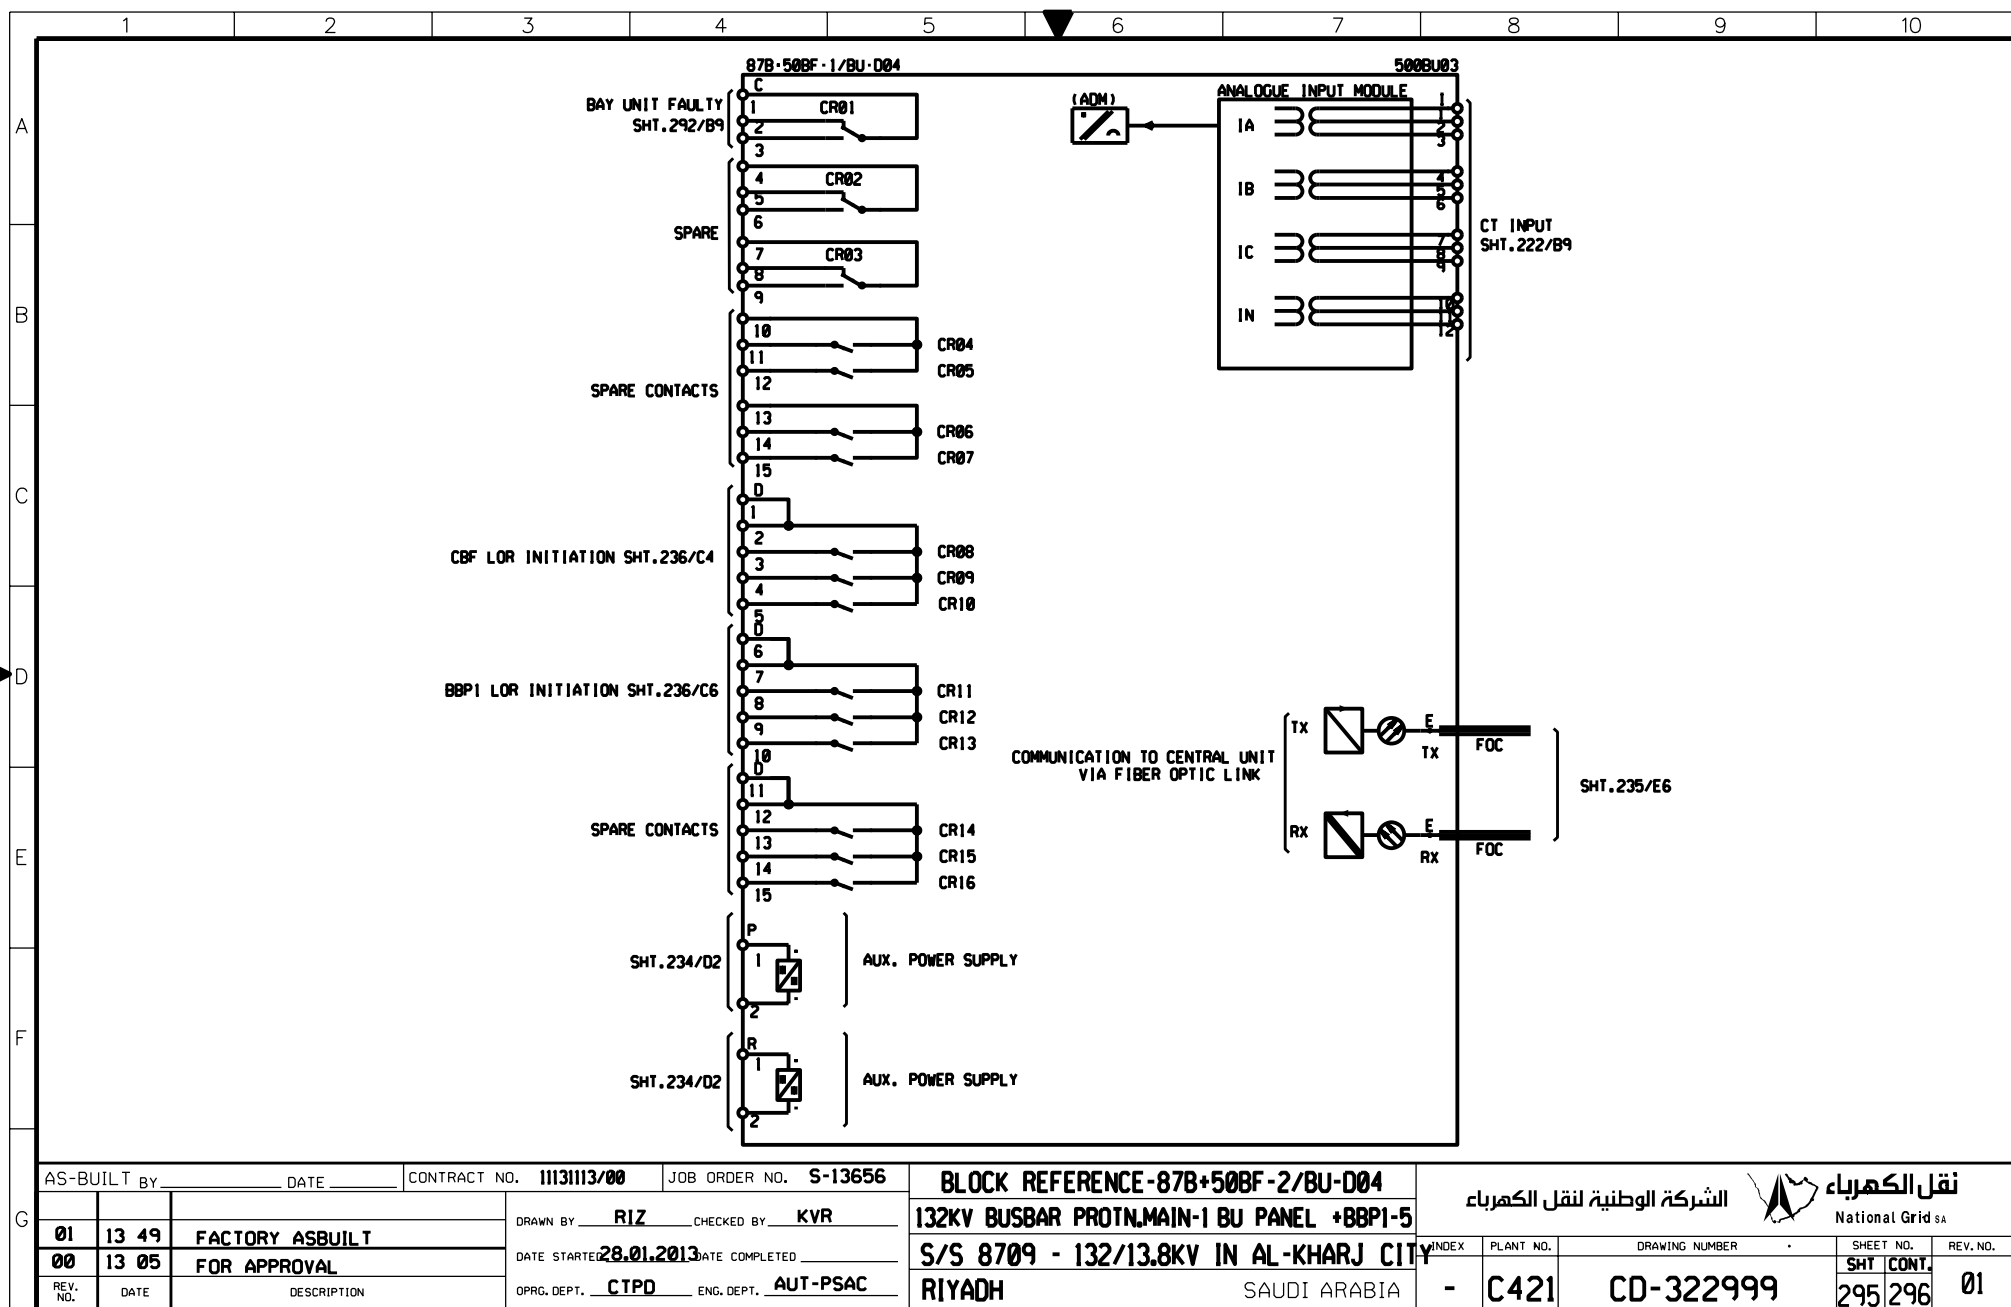


|   |  |  |                                 |  |                              |  |   |  |  |                              |             |                  |            |
|---|--|--|---------------------------------|--|------------------------------|--|---|--|--|------------------------------|-------------|------------------|------------|
| AS-BUILT BY _____ DATE _____                      |  |  | CONTRACT NO. <b>11131113/00</b> |  | JOB ORDER NO. <b>S-13656</b> |  | <b>BLOCK REFERENCE-87B+50BF-2/BU-D04</b>          |  |  | الشركة الوطنية لنقل الكهرباء |             |                  |            |
|   |  |  |                                 |  |                              |  | <b>132KV BUSBAR PROTN.MAIN-1 BU PANEL +BBPI-5</b> |  |  | National Grid sa             |             |                  |            |
| DRAWN BY <b>RIZ</b> CHECKED BY <b>KVR</b>         |  |  | DATE STARTED <b>28.01.2013</b>  |  | DATE COMPLETED _____         |  | <b>S/S 8709 - 132/13.8KV IN AL-KHARJ CITY</b>     |  |  | INDEX                        | PLANT NO.   | DRAWING NUMBER   | SHEET NO.  |
| PRG. DEPT. <b>CTPD</b> ENG. DEPT. <b>AUT-PSAC</b> |  |  |                                 |  |                              |  | <b>RIYADH SAUDI ARABIA</b>                        |  |  | -                            | <b>C421</b> | <b>CD-322999</b> | <b>295</b> |
| REV. NO. _____                                    |  |  | DATE _____                      |  | DESCRIPTION _____            |  |   |  |  |                              |             |                  | REV. NO.   |
|   |  |  |                                 |  |                              |  |   |  |  |                              |             |                  | <b>01</b>  |

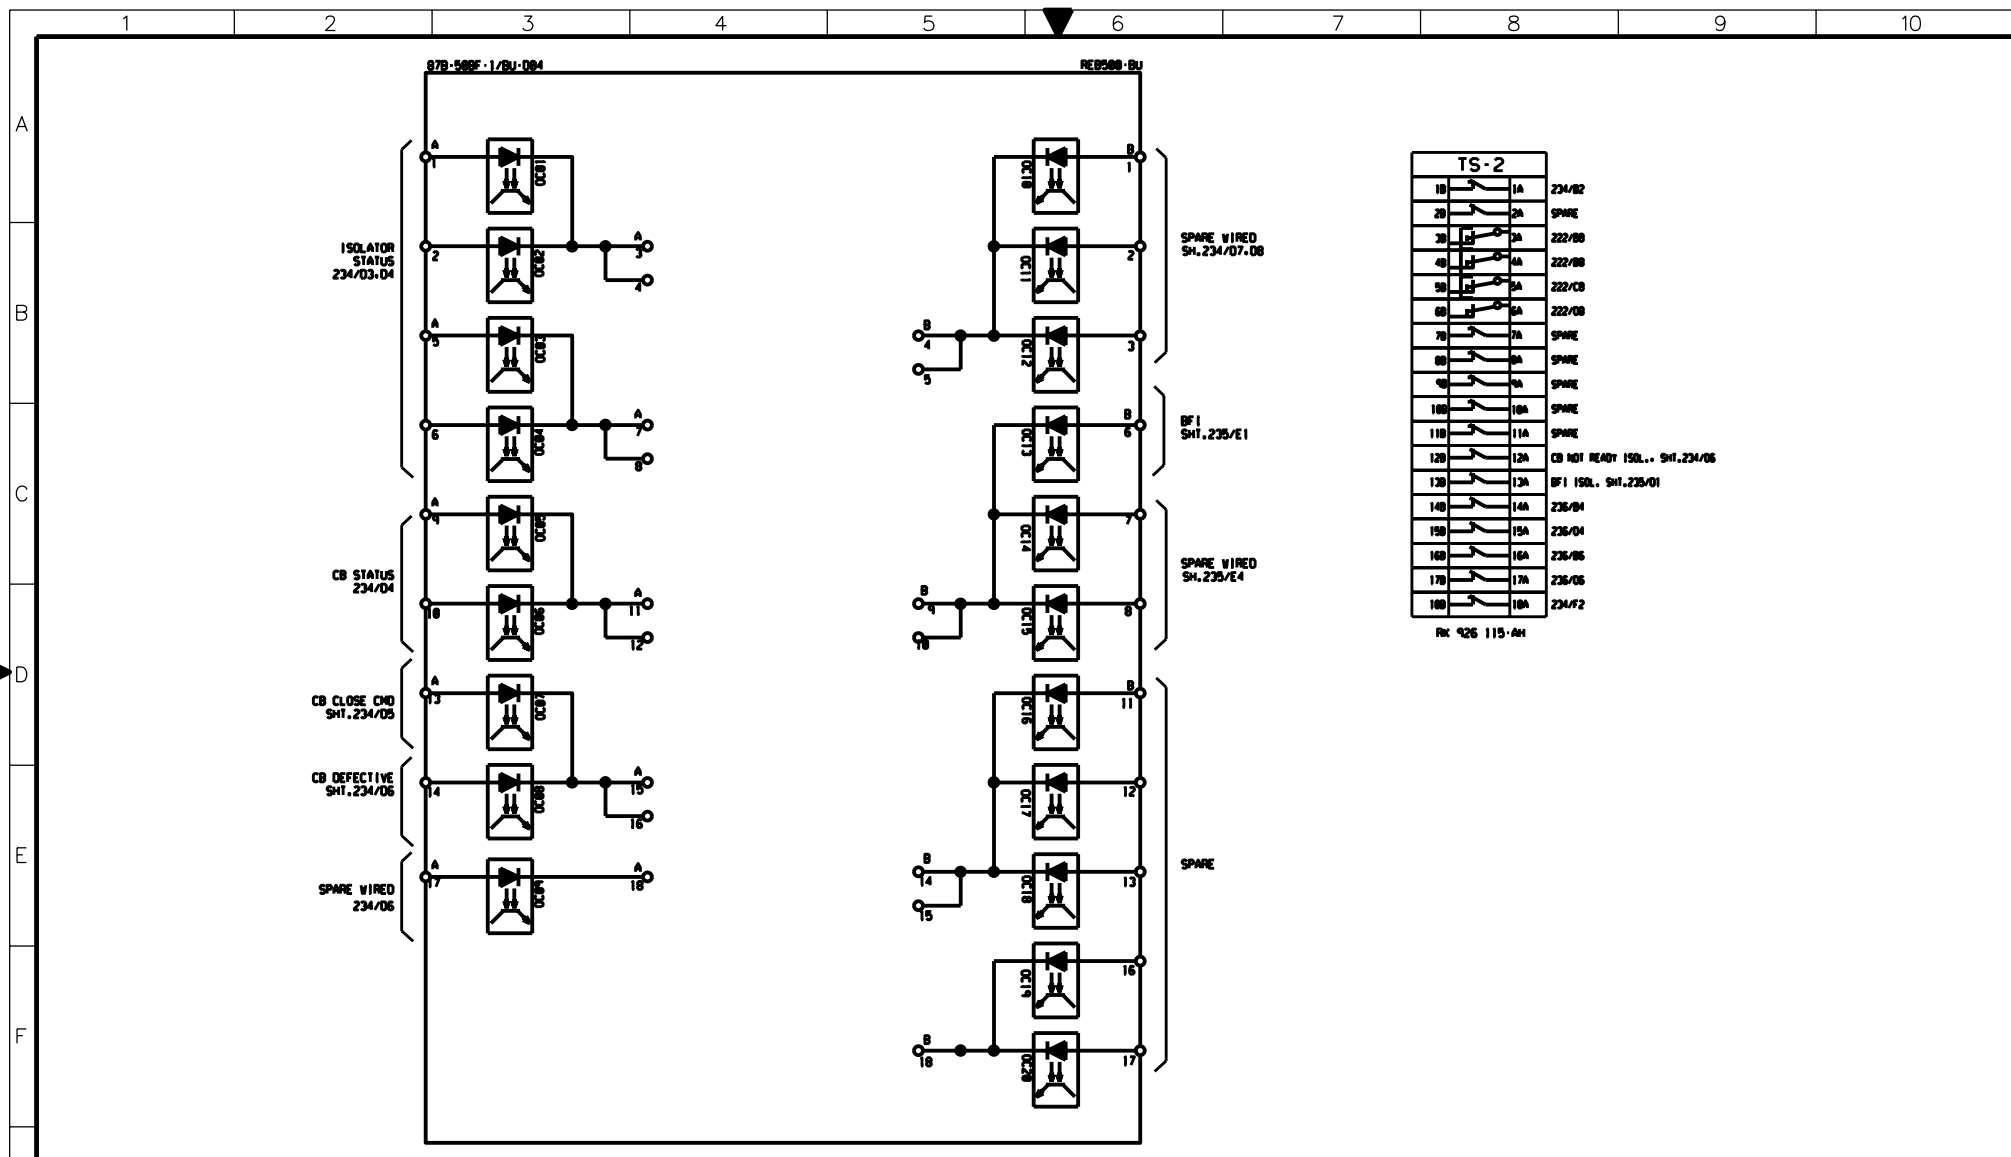


| TS-2          |     |                                 |  |
|---------------|-----|---------------------------------|--|
| 1B            | 1A  | 234/02                          |  |
| 2B            | 2A  | SPARE                           |  |
| 3B            | 3A  | 222/08                          |  |
| 4B            | 4A  | 222/08                          |  |
| 5B            | 5A  | 222/08                          |  |
| 6B            | 6A  | 222/08                          |  |
| 7B            | 7A  | SPARE                           |  |
| 8B            | 8A  | SPARE                           |  |
| 9B            | 9A  | SPARE                           |  |
| 10B           | 10A | SPARE                           |  |
| 11B           | 11A | SPARE                           |  |
| 12B           | 12A | CB NOT READY ISOL... SH1.234/06 |  |
| 13B           | 13A | BF I ISOL. SH1.235/01           |  |
| 14B           | 14A | 235/04                          |  |
| 15B           | 15A | 235/04                          |  |
| 16B           | 16A | 235/06                          |  |
| 17B           | 17A | 235/06                          |  |
| 18B           | 18A | 234/72                          |  |
| Rc 926 115-AM |     |                                 |  |

|   |  |   |  |   |  |   |  |                                 |  |                                       |  |
|---|--|---|--|---|--|---|--|---------------------------------|--|---------------------------------------|--|
| AS-BUILT BY _____ DATE _____              |  | CONTRACT NO. <b>1113113/00</b>                      |  | JOB ORDER NO. <b>S-13656</b>                      |  | <b>BLOCK REFERENCE-87B+50BF-2/BU-D04</b>          |  | الشركة الوطنية لنقل الكهرباء    |  | نقل الكهرباء                          |  |
| DRAWN BY <b>RIZ</b> CHECKED BY <b>KVR</b> |  | DATE STARTED <b>28.01.2013</b> DATE COMPLETED _____ |  | PRG. DEPT. <b>CTPD</b> ENG. DEPT. <b>AUT-PSAC</b> |  | <b>132KV BUSBAR PROTN.MAIN-1 BU PANEL +BBP1-5</b> |  | National Grid sa                |  |                                       |  |
| REV. NO. <b>01</b> DATE <b>13 49</b>      |  | DESCRIPTION <b>FACTORY ASBUILT</b>                  |  |   |  | <b>\$/S 8709 - 132/13.8KV IN AL-KHARJ CITY</b>    |  | INDEX <b>C421</b>               |  | PLANT NO. <b>CD-322999</b>            |  |
| REV. NO. <b>00</b> DATE <b>13 05</b>      |  | DESCRIPTION <b>FOR APPROVAL</b>                     |  |   |  | <b>RIYADH SAUDI ARABIA</b>                        |  | DRAWING NUMBER <b>CD-322999</b> |  | SHEET NO. <b>296</b> CONT. <b>297</b> |  |
|   |  |   |  |   |  |   |  |                                 |  | REV. NO. <b>01</b>                    |  |

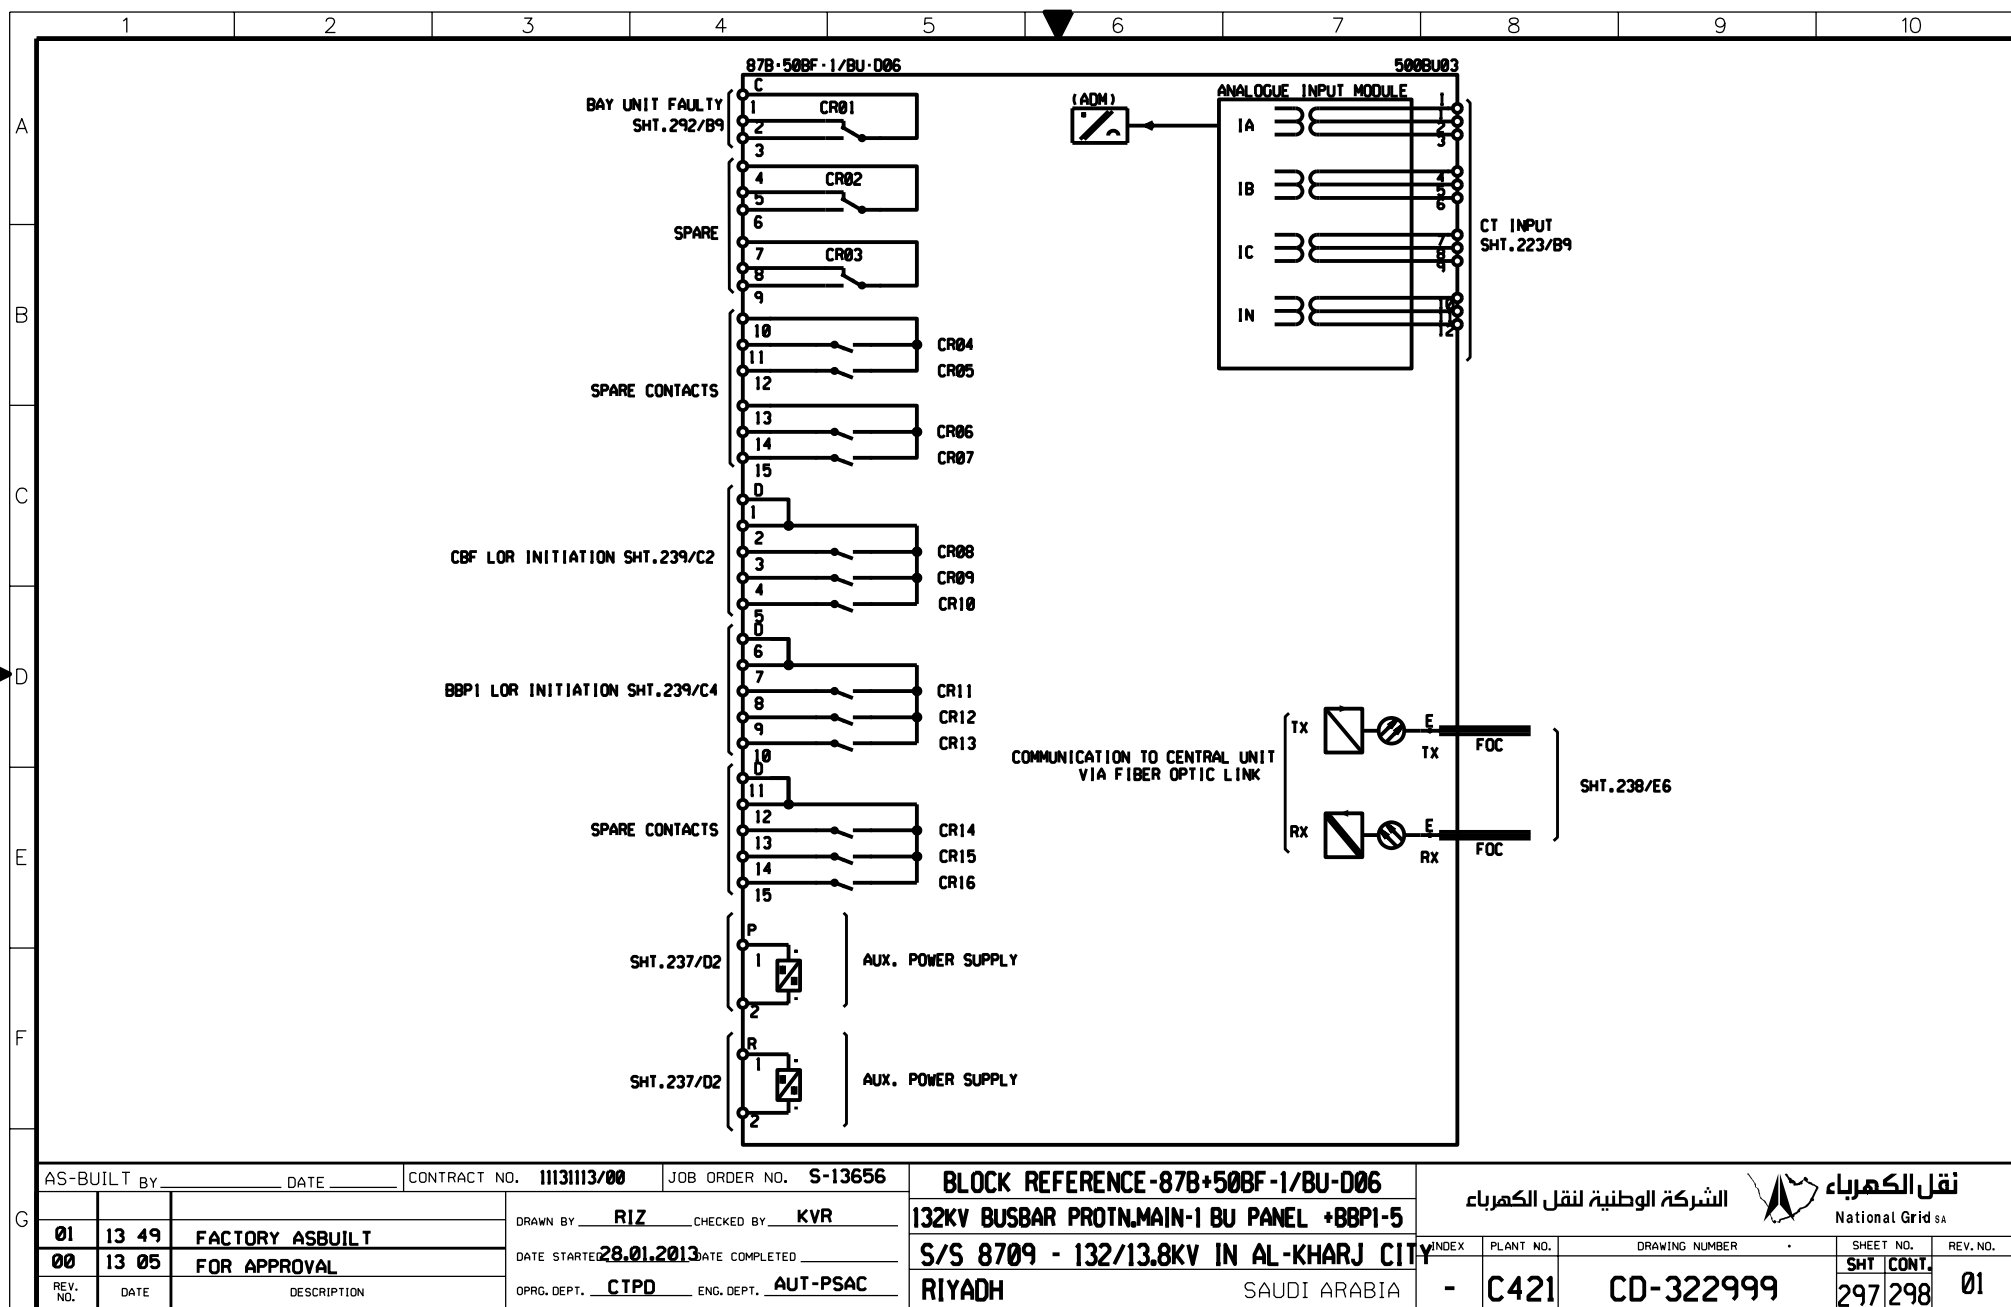



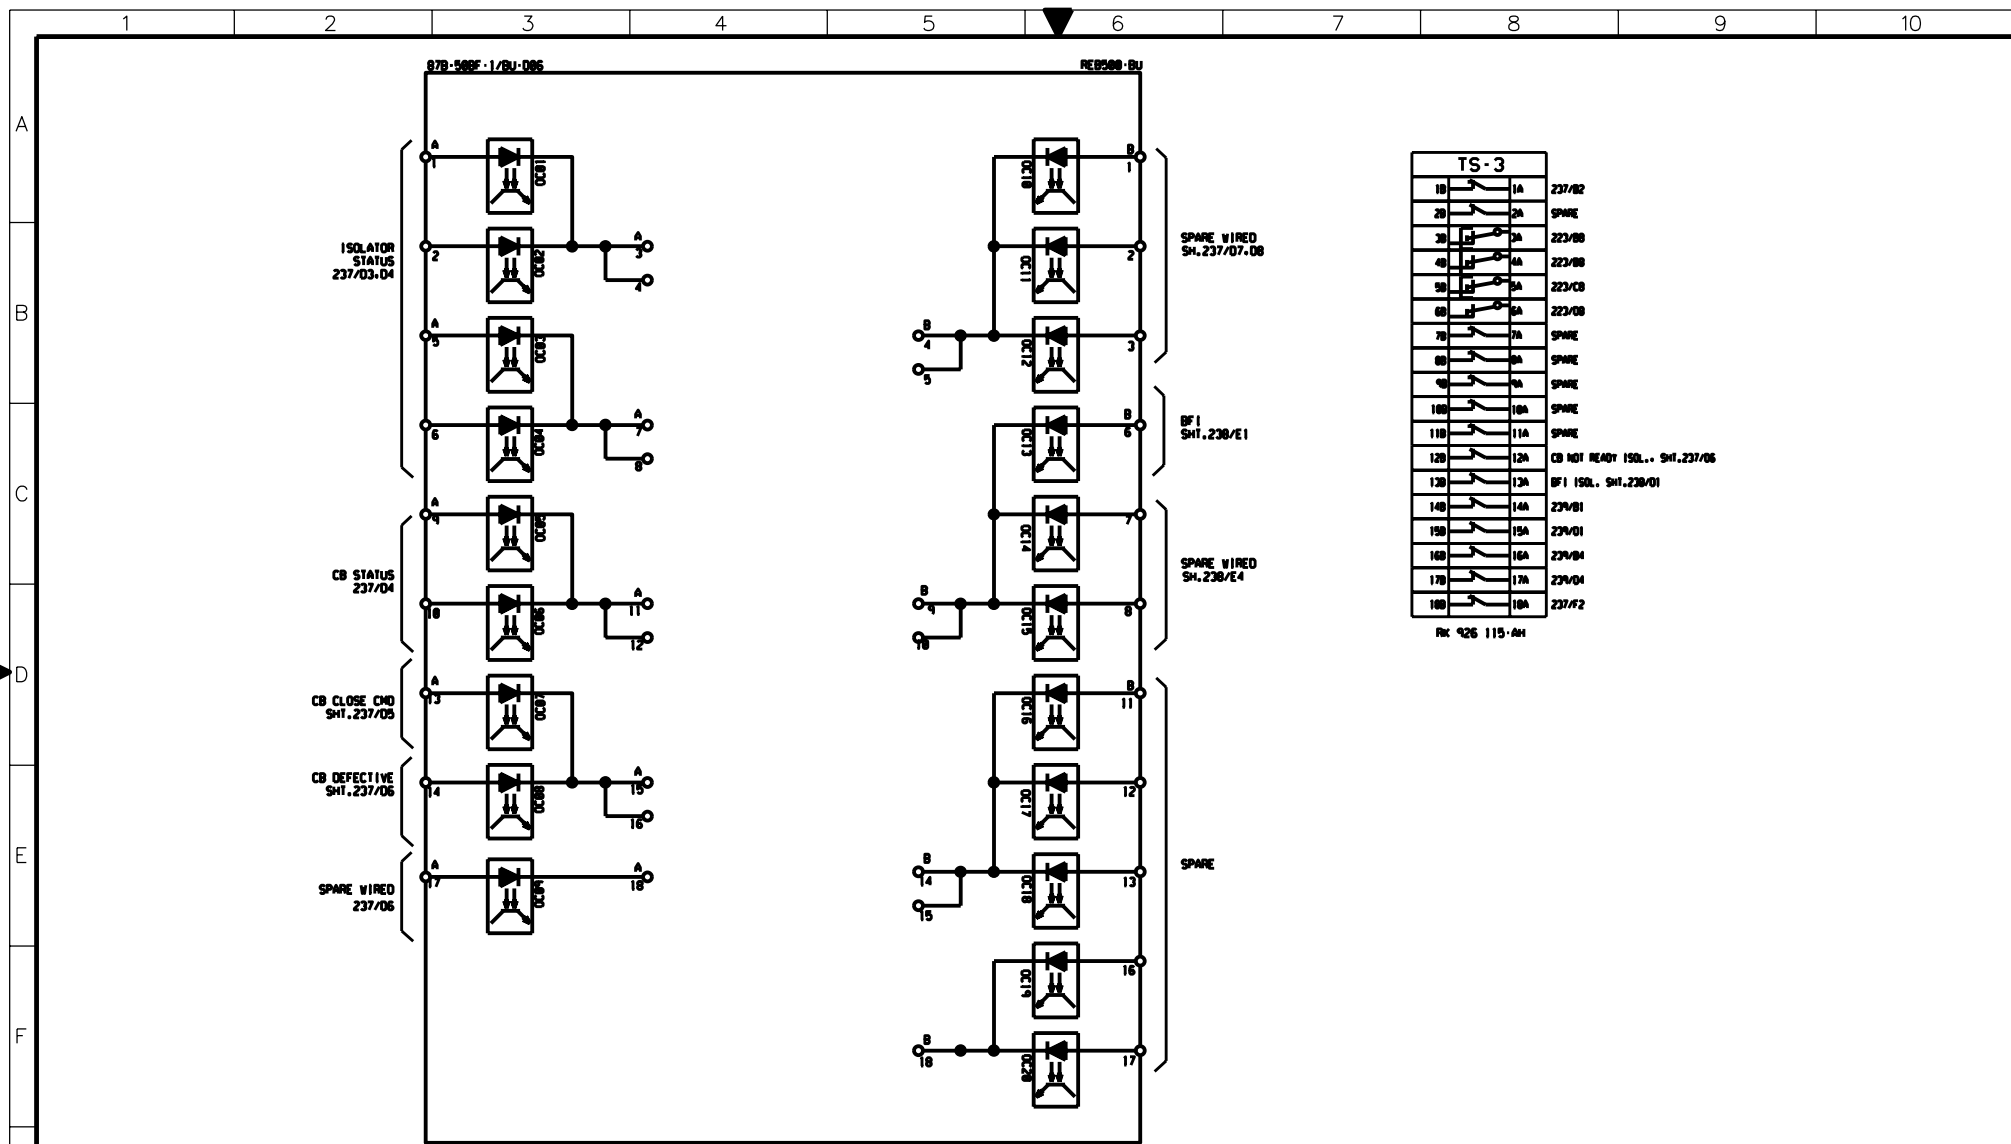

| TS-3 |     |                                 |
|------|-----|---------------------------------|
| 1B   | 1A  | 237/02                          |
| 2B   | 2A  | SPARE                           |
| 3B   | 3A  | 223/08                          |
| 4B   | 4A  | 223/08                          |
| 5B   | 5A  | 223/08                          |
| 6B   | 6A  | 223/08                          |
| 7B   | 7A  | SPARE                           |
| 8B   | 8A  | SPARE                           |
| 9B   | 9A  | SPARE                           |
| 10B  | 10A | SPARE                           |
| 11B  | 11A | SPARE                           |
| 12B  | 12A | CB NOT READY ISOL... SH1.237/06 |
| 13B  | 13A | BF I ISOL. SH1.238/01           |
| 14B  | 14A | 239/01                          |
| 15B  | 15A | 239/01                          |
| 16B  | 16A | 239/04                          |
| 17B  | 17A | 239/04                          |
| 18B  | 18A | 237/02                          |

RK 926 115-AM

AS-BUILT BY \_\_\_\_\_ DATE \_\_\_\_\_ CONTRACT NO. **1113113/00** JOB ORDER NO. **S-13656**

| 01       | 13 49 | FACTORY ASBUILT |
|----------|-------|-----------------|
| 00       | 13 05 | FOR APPROVAL    |
| REV. NO. | DATE  | DESCRIPTION     |

DRAWN BY **RIZ** CHECKED BY **KVR**  
 DATE STARTED **28.01.2013** DATE COMPLETED \_\_\_\_\_  
 OPRG. DEPT. **CTPD** ENG. DEPT. **AUT-PSAC**

**BLOCK REFERENCE-87B+50BF-1/BU-D06**  
**132KV BUSBAR PROT.N.MAIN-1 BU PANEL +B8P1-5**  
**S/S 8709 - 132/13.8KV IN AL-KHARJ CITY**  
**RIYADH SAUDI ARABIA**

| الشركة الوطنية لنقل الكهرباء |           | نقل الكهرباء     |           |          |
|------------------------------|-----------|------------------|-----------|----------|
| National Grid sa             |           | National Grid sa |           |          |
| INDEX                        | PLANT NO. | DRAWING NUMBER   | SHEET NO. | REV. NO. |
| -                            | C421      | CD-322999        | 298       | 01       |

|  |   |   |   |   |   |   |   |   |   |    |
|--|---|---|---|---|---|---|---|---|---|----|
|  | 1 | 2 | 3 | 4 | 5 | 6 | 7 | 8 | 9 | 10 |
|--|---|---|---|---|---|---|---|---|---|----|

|   |                  |                        |    |                  |  |    |                  |  |    |                  |  |    |                  |                          |    |                  |                       |    |
|---|------------------|------------------------|----|------------------|--|----|------------------|--|----|------------------|--|----|------------------|--------------------------|----|------------------|-----------------------|----|
| A | <b>REFERENCE</b> | <b>1X1<br/>CT CKT.</b> |    | <b>REFERENCE</b> | <b>1X51<br/>CON &amp; PROTIN CKTS.</b> |    | <b>REFERENCE</b> | <b>2X51<br/>CON &amp; PROTIN CKTS.</b> |    | <b>REFERENCE</b> | <b>3X51<br/>CON &amp; PROTIN CKTS.</b> |    | <b>REFERENCE</b> | <b>X61<br/>ALM. CKT.</b> |    | <b>REFERENCE</b> | <b>X3<br/>AC CKT.</b> |    |
|   |                  | 221/B7                 | 1  |                  | 231/A3                                 | 1  |                  | 234/A3                                 | 1  |                  | 237/A3                                 | 1  |                  | 212/E5                   | 1  |                  | 211/A3                | 1  |
|   |                  | 221/B7                 | 2  |                  | 231/A5                                 | 2  |                  | 234/A5                                 | 2  |                  | 237/A5                                 | 2  |                  | 212/E5                   | 2  |                  | 211/A7                | 2  |
|   |                  | 221/C7                 | 3  |                  | 231/A6                                 | 3  |                  | 234/A6                                 | 3  |                  | 237/A6                                 | 3  |                  | 292/E4                   | 3  |                  | 211/A3                | 3  |
|   |                  | 221/C7                 | 4  |                  | 231/A8                                 | 4  |                  | 234/A8                                 | 4  |                  | 237/A8                                 | 4  |                  | 292/E5                   | 4  |                  | 211/A7                | 4  |
|   |                  | 221/C7                 | 5  |                  | 232/A1                                 | 5  |                  | 235/A1                                 | 5  |                  | 238/A1                                 | 5  |                  | 292/E6                   | 5  |                  | 211/B3                | 5  |
|   |                  | 221/C7                 | 6  |                  | 232/A2                                 | 6  |                  | 235/A2                                 | 6  |                  | 238/A2                                 | 6  |                  | 292/E7                   | 6  |                  | 211/B7                | 6  |
|   |                  | 221/C7                 | 7  |                  | 232/A2                                 | 7  |                  | 235/A2                                 | 7  |                  | 238/A2                                 | 7  |                  | 292/E8                   | 7  |                  | 211/B3                | 7  |
|   |                  | 221/D7                 | 8  |                  | 232/A3                                 | 8  |                  | 235/A3                                 | 8  |                  | 238/A3                                 | 8  |                  | SPARE                    | 8  |                  | 211/B7                | 8  |
|   |                  | 221/D7                 | 9  |                  | 232/A4                                 | 9  |                  | 235/A4                                 | 9  |                  | 238/A4                                 | 9  |                  | SPARE                    | 9  |                  | SPARE                 | 9  |
| B |                  | 221/D7                 | 10 |                  | 232/A4                                 | 10 |                  | 235/A4                                 | 10 |                  | 238/A4                                 | 10 |                  | SPARE                    | 10 |                  | SPARE                 | 10 |
|   |                  | SPARE                  |    |                  | 231/C3                                 | 11 |                  | 234/C3                                 | 11 |                  | 237/C3                                 | 11 |                  | SPARE                    |    |                  | SPARE                 |    |
|   |                  |                        |    |                  | 231/C3                                 | 12 |                  | 234/C3                                 | 12 |                  | 237/C3                                 | 12 |                  | SPARE                    |    |                  | SPARE                 |    |
|   |                  |                        |    |                  | 231/C4                                 | 13 |                  | 234/C4                                 | 13 |                  | 237/C4                                 | 13 |                  | SPARE                    |    |                  | SPARE                 |    |
|   |                  |                        |    |                  | 231/C4                                 | 14 |                  | 234/C4                                 | 14 |                  | 237/C4                                 | 14 |                  | SPARE                    |    |                  | SPARE                 |    |
|   |                  |                        |    |                  | 231/C4                                 | 15 |                  | 234/C4                                 | 15 |                  | 237/C4                                 | 15 |                  | SPARE                    |    |                  | SPARE                 |    |
|   |                  |                        |    |                  | 231/C5                                 | 16 |                  | 234/C5                                 | 16 |                  | 237/C5                                 | 16 |                  | SPARE                    |    |                  | SPARE                 |    |
|   |                  |                        |    |                  | 231/C5                                 | 17 |                  | 234/C5                                 | 17 |                  | 237/C5                                 | 17 |                  | SPARE                    |    |                  | SPARE                 |    |
|   |                  |                        |    |                  | 231/C6                                 | 18 |                  | 234/C6                                 | 18 |                  | 237/C6                                 | 18 |                  | SPARE                    |    |                  | SPARE                 |    |
|   |                  |                        |    |                  | 231/C6                                 | 19 |                  | 234/C6                                 | 19 |                  | 237/C6                                 | 19 |                  | SPARE                    |    |                  | SPARE                 |    |
| C |                  |                        |    |                  | 231/C7                                 | 20 |                  | 234/C7                                 | 20 |                  | 237/C7                                 | 20 |                  |                          |    |                  |                       |    |
|   |                  |                        |    |                  | 231/C8                                 | 21 |                  | 234/C8                                 | 21 |                  | 237/C8                                 | 21 |                  |                          |    |                  |                       |    |
|   |                  |                        |    |                  | 231/C8                                 | 22 |                  | 234/C8                                 | 22 |                  | 237/C8                                 | 22 |                  |                          |    |                  |                       |    |
|   |                  |                        |    |                  | 232/D1                                 | 23 |                  | 235/D1                                 | 23 |                  | 238/D1                                 | 23 |                  |                          |    |                  |                       |    |
|   |                  |                        |    |                  | 232/C1                                 | 24 |                  | 235/C1                                 | 24 |                  | 238/C1                                 | 24 |                  |                          |    |                  |                       |    |
|   |                  |                        |    |                  | 232/C3                                 | 25 |                  | 235/C3                                 | 25 |                  | 238/C3                                 | 25 |                  |                          |    |                  |                       |    |
|   |                  |                        |    |                  | 232/D4                                 | 26 |                  | 235/D4                                 | 26 |                  | 238/D4                                 | 26 |                  |                          |    |                  |                       |    |
|   |                  |                        |    |                  | 232/D5                                 | 27 |                  | 235/D5                                 | 27 |                  | 238/D5                                 | 27 |                  |                          |    |                  |                       |    |
|   |                  |                        |    |                  | 232/B8                                 | 28 |                  | 235/B8                                 | 28 |                  | 238/B8                                 | 28 |                  |                          |    |                  |                       |    |
|   |                  |                        |    |                  | 232/F8                                 | 29 |                  | 235/F8                                 | 29 |                  | 238/F8                                 | 29 |                  |                          |    |                  |                       |    |
| D |                  |                        |    |                  | 232/B8                                 | 30 |                  | 235/B8                                 | 30 |                  | 238/B8                                 | 30 |                  |                          |    |                  |                       |    |
|   |                  |                        |    |                  | 232/F8                                 | 31 |                  | 235/F8                                 | 31 |                  | 238/F8                                 | 31 |                  |                          |    |                  |                       |    |
|   |                  |                        |    |                  | 233/E4                                 | 32 |                  | 236/E4                                 | 32 |                  | 239/E4                                 | 32 |                  |                          |    |                  |                       |    |
|   |                  |                        |    |                  | 233/E4                                 | 33 |                  | 236/E4                                 | 33 |                  | 239/E4                                 | 33 |                  |                          |    |                  |                       |    |
|   |                  |                        |    |                  | 233/E6                                 | 34 |                  | 236/E6                                 | 34 |                  | 239/E6                                 | 34 |                  |                          |    |                  |                       |    |
|   |                  |                        |    |                  | 233/E7                                 | 35 |                  | 236/E7                                 | 35 |                  | 239/E7                                 | 35 |                  |                          |    |                  |                       |    |
|   |                  |                        |    |                  | SPARE                                  | 36 |                  | SPARE                                  | 36 |                  | SPARE                                  | 36 |                  |                          |    |                  |                       |    |
|   |                  |                        |    |                  | SPARE                                  | 37 |                  | SPARE                                  | 37 |                  | SPARE                                  | 37 |                  |                          |    |                  |                       |    |
|   |                  |                        |    |                  | SPARE                                  | 38 |                  | SPARE                                  | 38 |                  | SPARE                                  | 38 |                  |                          |    |                  |                       |    |
|   |                  |                        |    |                  | SPARE                                  | 39 |                  | SPARE                                  | 39 |                  | SPARE                                  | 39 |                  |                          |    |                  |                       |    |
| E |                  |                        |    |                  | SPARE                                  | 40 |                  | SPARE                                  | 40 |                  | SPARE                                  | 40 |                  |                          |    |                  |                       |    |
|   |                  |                        |    |                  |  |    |                  |  |    |                  |  |    |                  |                          |    |                  |                       |    |
|   |                  |                        |    |                  |  |    |                  |  |    |                  |  |    |                  |                          |    |                  |                       |    |
| F |                  |                        |    |                  |  |    |                  |  |    |                  |  |    |                  |                          |    |                  |                       |    |
|   |                  |                        |    |                  |  |    |                  |  |    |                  |  |    |                  |                          |    |                  |                       |    |
|   |                  |                        |    |                  |  |    |                  |  |    |                  |  |    |                  |                          |    |                  |                       |    |
|                  |                        |    |                  |                        |    |                  |                       |    |                  |                             |   |                  |                         |   |
|------------------|------------------------|----|------------------|------------------------|----|------------------|-----------------------|----|------------------|-----------------------------|---|------------------|-------------------------|---|
| <b>REFERENCE</b> | <b>2X1<br/>CT CKT.</b> |    | <b>REFERENCE</b> | <b>X4<br/>DC CKTS.</b> |    | <b>REFERENCE</b> | <b>XTJ<br/>T.JACK</b> |    | <b>REFERENCE</b> | <b>XSH<br/>SPACE HEATER</b> |   | <b>REFERENCE</b> | <b>X6<br/>ALM. CKT.</b> |   |
|                  | 222/B7                 | 1  |                  | 216/B3                 | 1  |                  | 211/C3                | 1  |                  | 211/E6                      | 1 |                  | 212/C5                  | 1 |
|                  | 222/B7                 | 2  |                  | 216/B3                 | 2  |                  | 211/D3                | 2  |                  | 211/F6                      | 2 |                  | 212/C5                  | 2 |
|                  | 222/C7                 | 3  |                  | 216/D3                 | 3  |                  | 211/D3                | 3  |                  | SPARE                       | 3 |                  | 292/E3                  | 3 |
|                  | 222/C7                 | 4  |                  |                        | 4  |                  | SPARE                 | 4  |                  | SPARE                       | 4 |                  | SPARE                   | 4 |
|                  | 222/C7                 | 5  |                  |                        | 5  |                  | SPARE                 | 5  |                  |                             | 5 |                  |                         | 5 |
|                  | 222/C7                 | 6  |                  |                        | 6  |                  | SPARE                 | 6  |                  |                             |   |                  |                         |   |
|                  | 222/C7                 | 7  |                  |                        | 7  |                  | SPARE                 | 7  |                  |                             |   |                  |                         |   |
|                  | 222/D7                 | 8  |                  |                        | 8  |                  | SPARE                 | 8  |                  |                             |   |                  |                         |   |
|                  | 222/D7                 | 9  |                  |                        | 9  |                  | SPARE                 | 9  |                  |                             |   |                  |                         |   |
|                  | SPARE                  | 10 |                  |                        | 10 |                  | SPARE                 | 10 |                  |                             |   |                  |                         |   |

|                  |                        |------------------|------------------------|----|------------------|--------------------------|----|------------------|-----------------------|----|------------------|------------------------|----|------------------|-----------------------|----|------------------|-----------------------------|---|------------------|-------------------------|---|
| <b>REFERENCE</b> | <b>3X1<br/>CT CKT.</b> |    | <b>REFERENCE</b> | <b>X61<br/>ALM. CKT.</b> |    | <b>REFERENCE</b> | <b>X3<br/>AC CKT.</b> |    | <b>REFERENCE</b> | <b>X4<br/>DC CKTS.</b> |    | <b>REFERENCE</b> | <b>XTJ<br/>T.JACK</b> |    | <b>REFERENCE</b> | <b>XSH<br/>SPACE HEATER</b> |   | <b>REFERENCE</b> | <b>X6<br/>ALM. CKT.</b> |   |
|                  | 223/B7                 | 1  |                  | 216/B3                   | 1  |                  | 211/C3                | 1  |                  | 216/B3                 | 1  |                  | 211/C3                | 1  |                  | 211/E6                      | 1 |                  | 212/C5                  | 1 |
|                  | 223/B7                 | 2  |                  | 216/B3                   | 2  |                  | 211/D3                | 2  |                  | 216/B3                 | 2  |                  | 211/D3                | 2  |                  | 211/F6                      | 2 |                  | 212/C5                  | 2 |
|                  | 223/C7                 | 3  |                  | 216/D3                   | 3  |                  | 211/D3                | 3  |                  | 216/D3                 | 3  |                  | 211/D3                | 3  |                  | SPARE                       | 3 |                  | 292/E3                  | 3 |
|                  | 223/C7                 | 4  |                  |                          | 4  |                  | SPARE                 | 4  |                  |                        | 4  |                  | SPARE                 | 4  |                  | SPARE                       | 4 |                  | SPARE                   | 4 |
|                  | 223/C7                 | 5  |                  |                          | 5  |                  | SPARE                 | 5  |                  |                        | 5  |                  | SPARE                 | 5  |                  |                             | 5 |                  |                         | 5 |
|                  | 223/C7                 | 6  |                  |                          | 6  |                  | SPARE                 | 6  |                  |                        | 6  |                  | SPARE                 | 6  |                  |                             |   |                  |                         |   |
|                  | 223/C7                 | 7  |                  |                          | 7  |                  | SPARE                 | 7  |                  |                        | 7  |                  | SPARE                 | 7  |                  |                             |   |                  |                         |   |
|                  | 223/D7                 | 8  |                  |                          | 8  |                  | SPARE                 | 8  |                  |                        | 8  |                  | SPARE                 | 8  |                  |                             |   |                  |                         |   |
|                  | 223/D7                 | 9  |                  |                          | 9  |                  | SPARE                 | 9  |                  |                        | 9  |                  | SPARE                 | 9  |                  |                             |   |                  |                         |   |
|                  | SPARE                  | 10 |                  |                          | 10 |                  | SPARE                 | 10 |                  |                        | 10 |                  | SPARE                 | 10 |                  |                             |   |                  |                         |   |

AS-BUILT BY \_\_\_\_\_ DATE \_\_\_\_\_ CONTRACT NO. **11131113/00** JOB ORDER NO. **S-13656**

|          |       |                 |   |
|----------|-------|-----------------|---|
| 01       | 13 49 | FACTORY ASBUILT | DRAWN BY <b>RIZ</b> CHECKED BY <b>KVR</b>           |
| 00       | 13 05 | FOR APPROVAL    | DATE STARTED <b>28.01.2013</b> DATE COMPLETED _____ |
| REV. NO. | DATE  | DESCRIPTION     | OPRG. DEPT. <b>CTPD</b> ENG. DEPT. <b>AUT-PSAC</b>  |

**TERMINAL BLOCKS PANEL +BB1-5**  
**132KV BUSBAR PROTIN.MAIN-1 BU PANEL +BBPI-5**  
**S/S 8709 - 132/13.8KV IN AL-KHARJ CITY**  
**RIYADH SAUDI ARABIA**

|  |           |                |                       |
|--|-----------|----------------|-----------------------|
| الشركة الوطنية لنقل الكهرباء<br>National Grid sa |           | نقل الكهرباء   |                       |
| INDEX  | PLANT NO. | DRAWING NUMBER | SHEET NO.             |
| -  | C421      | CD-322999      | 301 NIL               |
|  |           |                | REV. NO.<br><b>01</b> |